IREDELL COUNTY HEALTH DEPARTMENT

...ATESVILLE 704-878-5305 MOORESVILLE 704-664-5281

IMPROVEMENT PERMIT / AUTHORIZATION TO CONSTRUCT / OPERATION PERMIT / EXISTING SYSTEM INSPECTION

PERMIT# 078720 PIN# ~~4625 94 1684~~ 4626 90 0430 DATE 3/25/00

OWNER OR CONTRACTOR Carolina Centers LLC; John R. Poore Bldrs PHONE: Business 664-1070 Home

ADDRESS PO Box 1003 Charlotte, NC 28201 P.O. Box 1437 Matthews 847-0446

LOCATION 1100 TL Direct Point TL Wild Harbor, on (L) corner 23104 lot.

SUBDIVISION Pointe BLOCK / SECTION 3 LOT 371 LOT AREA .799 SITE CLASS. PS DESIGN FLOW 480 L.T.A.R. .3

Septic Tank: 1060 Gallons: STB 338 Date 5/19/00

Pump Tank: 1000 Gallons: PT 283 Date 9/24/00

Pump Make: MYERS Model ME50-S21 Serial No. 212263

Nitrification Field: No. Fields 1 Square Feet 1200 Linear Feet 400

No. Lines 4 Trench Width 36 Max Trench Bottom Depth 36

[X] New System [ ] Repair System Type: I, II, (III) IV, V, VI

System Description: HOS on Cliff Plastic

Repair System Description: 16" PPDS

Maintenance Agreement Required: [ ] Yes [ ] No

~~Gravel Depth~~ SAND [ ] Slab [X] Crawl Space [ ] Basement w/plumbing [ ] Basement wo/plumbing

[X] House/Mod. Home No. Bedrooms 4

[ ] Mobile Home No. Bathrooms 4


[ ] Business No. Employees

[ ] Other

Water Supply: [ ] Individual [ ] Public [X] Community

Comments:/Conditions:


INITIAL SITE SKETCH

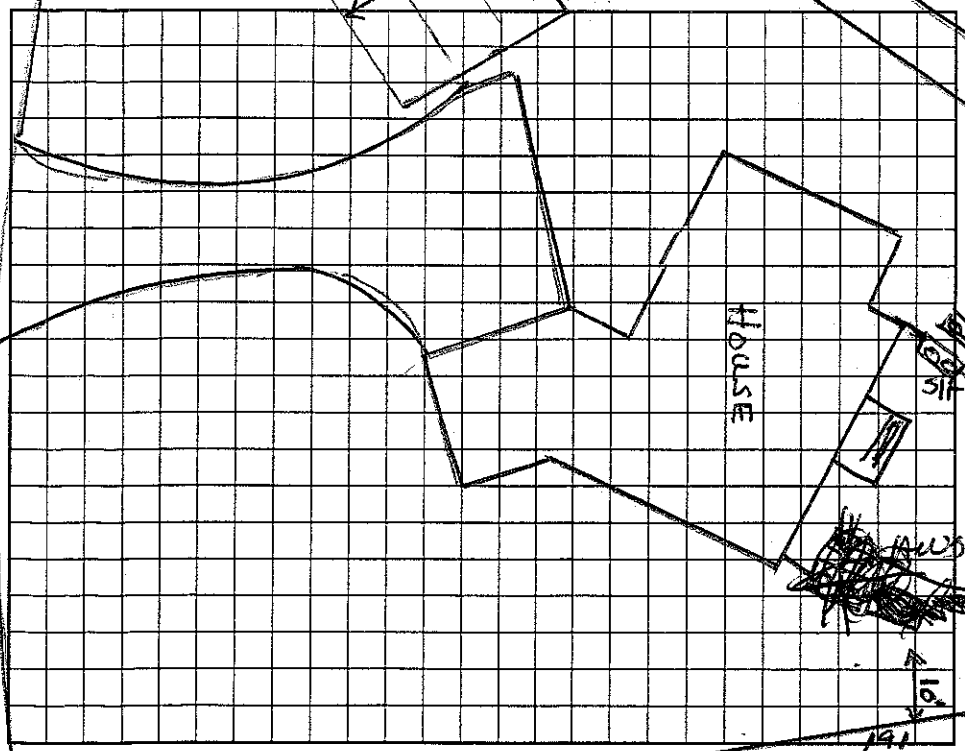

Comments:/Conditions:

EZ Flow installed.
1/13/01 Tank location shown.
Sprinkler system installed through drainfield area. tws

AS-BUILT SKETCH

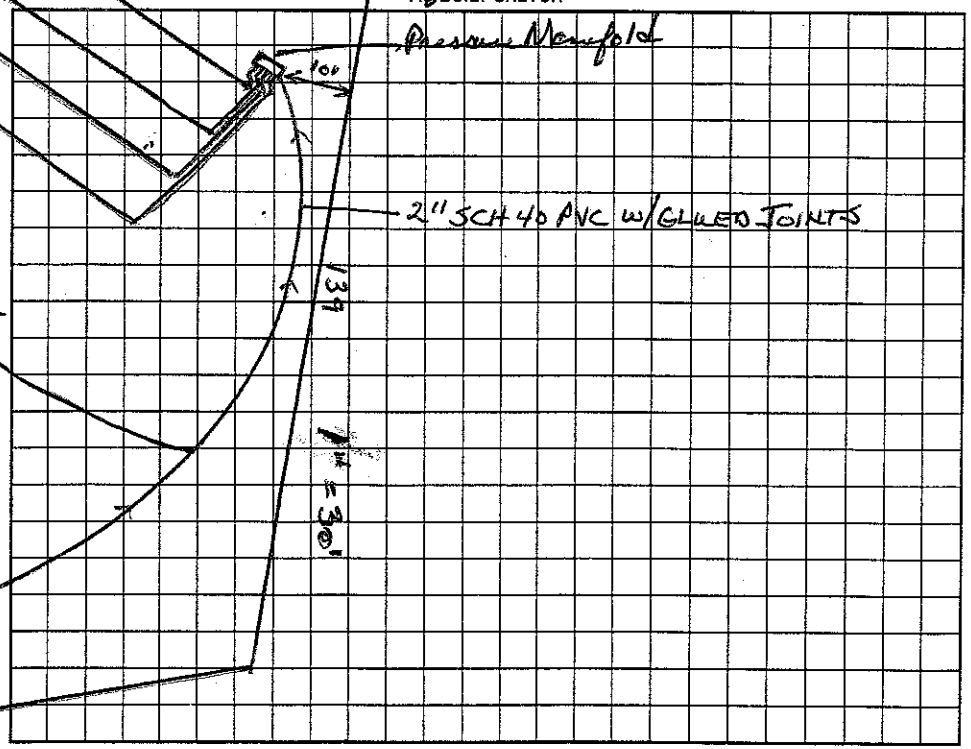

Permit can be suspended or revoked if any false information is supplied toward securing the permit/any unauthorized changes are made to the site/any unauthorized changes are made in the installation of the system. Improvement Permit with plat valid without expiration. Improvement Permit with site plan valid for sixty months. Authorization to Construct is valid for a period equal to that of Improvement Permit – not to exceed sixty months.

Signed: * FOR JOHN R. POORE BLDR date 3-25-00 Installed by: Hanley Septic Tank

Improvement Permit by: Wesley Sparks R.S. date 3/25/00 Operation Permit by: Wesley Sparks R.S. date 1/12/01

Authorization to Construct by: Wesley Sparks R.S. date 3/25/00 Existing System Inspection by: date

HEALTH DEPT. COPY: WHITE OWNER COPY (FINAL): YELLOW OWNER COPY (INITIAL): PINK