IREDELL COUNTY HEALTH DEPARTMENT

STATESVILLE 704-878-5305 MOORESVILLE 704-664-5281

IMPROVEMENT PERMIT / AUTHORIZATION TO CONSTRUCT / OPERATION PERMIT / EXISTING SYSTEM INSPECTION

PERMIT # 174088 PIN # 4629005384626900538 DATE 8-16-12

OWNER or APPLICANT David Dibble Custom Homes PHONE: Business 704 309-0784 Home:

OWNER or APPLICANT ADDRESS P.O. Box 4717 Mooresville NC 28117

LOCATION / DIRECTIONS Brawley School Rd TL Great Point Dr. TL Wild Harbor Rd on left

SUBDIVISION The Point BLOCK / SECTION III LOT # 370 LOT AREA 36,559 DESIGN FLOW 480gpd L.T.A.R. .3

Septic Tank min 1000 Gallons: STB 444 Date 3-7-13

Pump Tank 1000 Gallons: PT 27 Date 3-9-13

Pump Make Orenco Model PF2HP Serial #

Nitrification Field No Fields 1 No Lines 6 Linear Feet 270'

Trench Width min 24" Max. Trench Bottom Depth 36" Gravel Depth N/A

Biotube Easy Pay

☒ New System ☐ Repair ☐ Expansion System Type I II III (IV) V VI

System Description: Pump-LP Panel Black

Repair System Description: Same

Maintenance Agreement Required ☒ YES ☐ NO

☐ GRAVITY ☒ PRESSURE


☐ Residence No. Bedrooms ☐ Business No. Persons ☐ Other No. Employees ☐ Slab ☐ Crawl Space ☐ Basement w/plumbing ☐ Basement w/o plumbing

Water Supply ☐ Private ☐ Public ☐ Community

Comments / Conditions: Follow specifications in Crescent Communities Manual.

Comments / Conditions: Note: OK to move House closer to road but do not move any further back.

INITIAL SITE SKETCH

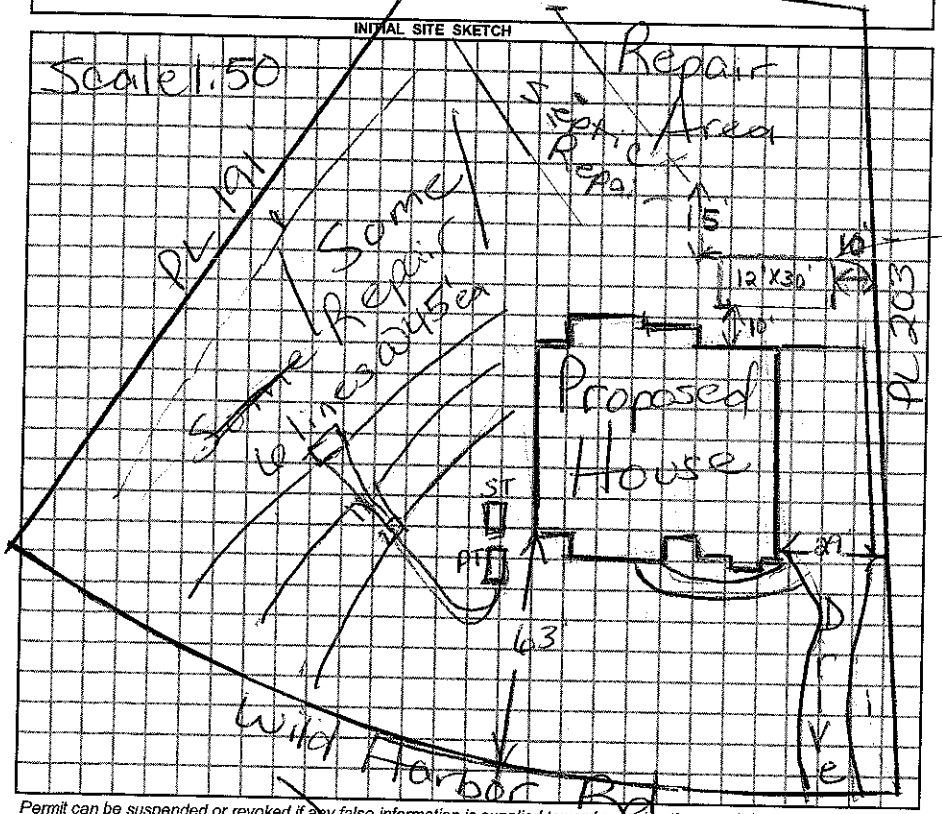

AS BUILT SKETCH

Drilled 3/16" hole in panels 4/11/13 Checked tanks, lines & set pressure.

Possible Pool 12'X30'

Permit can be suspended or revoked if any false information is supplied toward securing the permit / any unauthorized changes are made to the site / any unauthorized changes are made in the installation of the system.

☐ *IMPROVEMENT PERMIT w/ plat valid without expiration.* ☐ *IMPROVEMENT PERMIT w / site plan valid for 60 mos.* ☐ *AUTHORIZATION TO CONSTRUCT valid for period equal to IMPROVEMENT PERMIT-not to exceed 60 mo.*

Owner / Applicant Signature: Date

Improvement Permit by: Maint Tech Evan B.S. Date 8/16/12

Authorization to Construct by: Maint Tech Evan B.S. Date 8/16/12

YOU SHOULD CONTACT A LOCATOR SERVICE PRIOR TO ANY EXCAVATION.

Installed by: C Wayne Robison RS

Operation Permit by: Maint Tech Evan B.S. Date: 6/14/13

Existing System Inspected by: Date:

WHITE COPY Environmental Health YELLOW COPY (Final) Owner / Applicant PINK COPY (Initial) Owner / Applicant