462690092

IREDELL COUNTY HEALTH DEPARTMENT

STATESVILLE 704-878-5305 MOORESVILLE 704-6…

IMPROVEMENT PERMIT / AUTHORIZATION TO CONSTRUCT / OPERATION PERMIT / EXISTING SYSTEM I… …ECTION

PERMIT# 078499 PIN# 4625941684 pt

OWNER OR CONTRACTOR Crescent / Arcadia Dan Goetz 4626900927 DATE 8-25-04

ADDRESS P.O. Box 471941 Charlotte, NC 28247 PHONE: Business 201-7181 Home 662-6631

LOCATION Brawley School Rd TL Great Point Drive TL Wild Harbor Rd 6th lot on right - SFE on left past Bells G…

SUBDIVISION The Point BLOCK / SECTION III LOT 299/299A LOT AREA 32,984± 24,564 SITE CLASS. PS DESIGN FLOW 480gpd L.T.A.R. .3

Septic Tank: 1500 Gallons; STB ??? Date 7-15-05

Pump Tank: 1000 Gallons; PT ??? Date …

Pump Make: ______ Model ______ Serial No. ______

Nitrification Field: No Fields 1 Square Feet 1500' Linear Feet 500'

No Lines 4 @ 125' Trench Width 36" Max Trench Bottom Depth 36" Gravel Depth N/A

☒ New System ☐ Repair System Type: I, II, (III), IV, V, VI

System Description: pump - pm - 25% Reduction

Repair System Description: LP - pump - 25-50% Reduction

Maintenance Agreement Required: ☐ Yes ☒ No

☒ House/Mod. Home ☐ Mobile Home ☐ Business ☐ Other

No. Bedrooms 5 No. Bathrooms 5 No. Employees ______

☐ Slab ☐ Crawl Space ☒ Basement w/plumbing ☐ Basement wo/plumbing


Water Supply: ☐ Individual ☒ Public ☒ Community

Comments/Conditions: Keep Septic System at least 10' to PL & 50' from lake


Comments/Conditions: Dwyer…? WS Checked lines 7/28/05, installed EZ Flow. Doors, elect & alarm 9/16/05

Scale 1:160

INITIAL SITE SKETCH

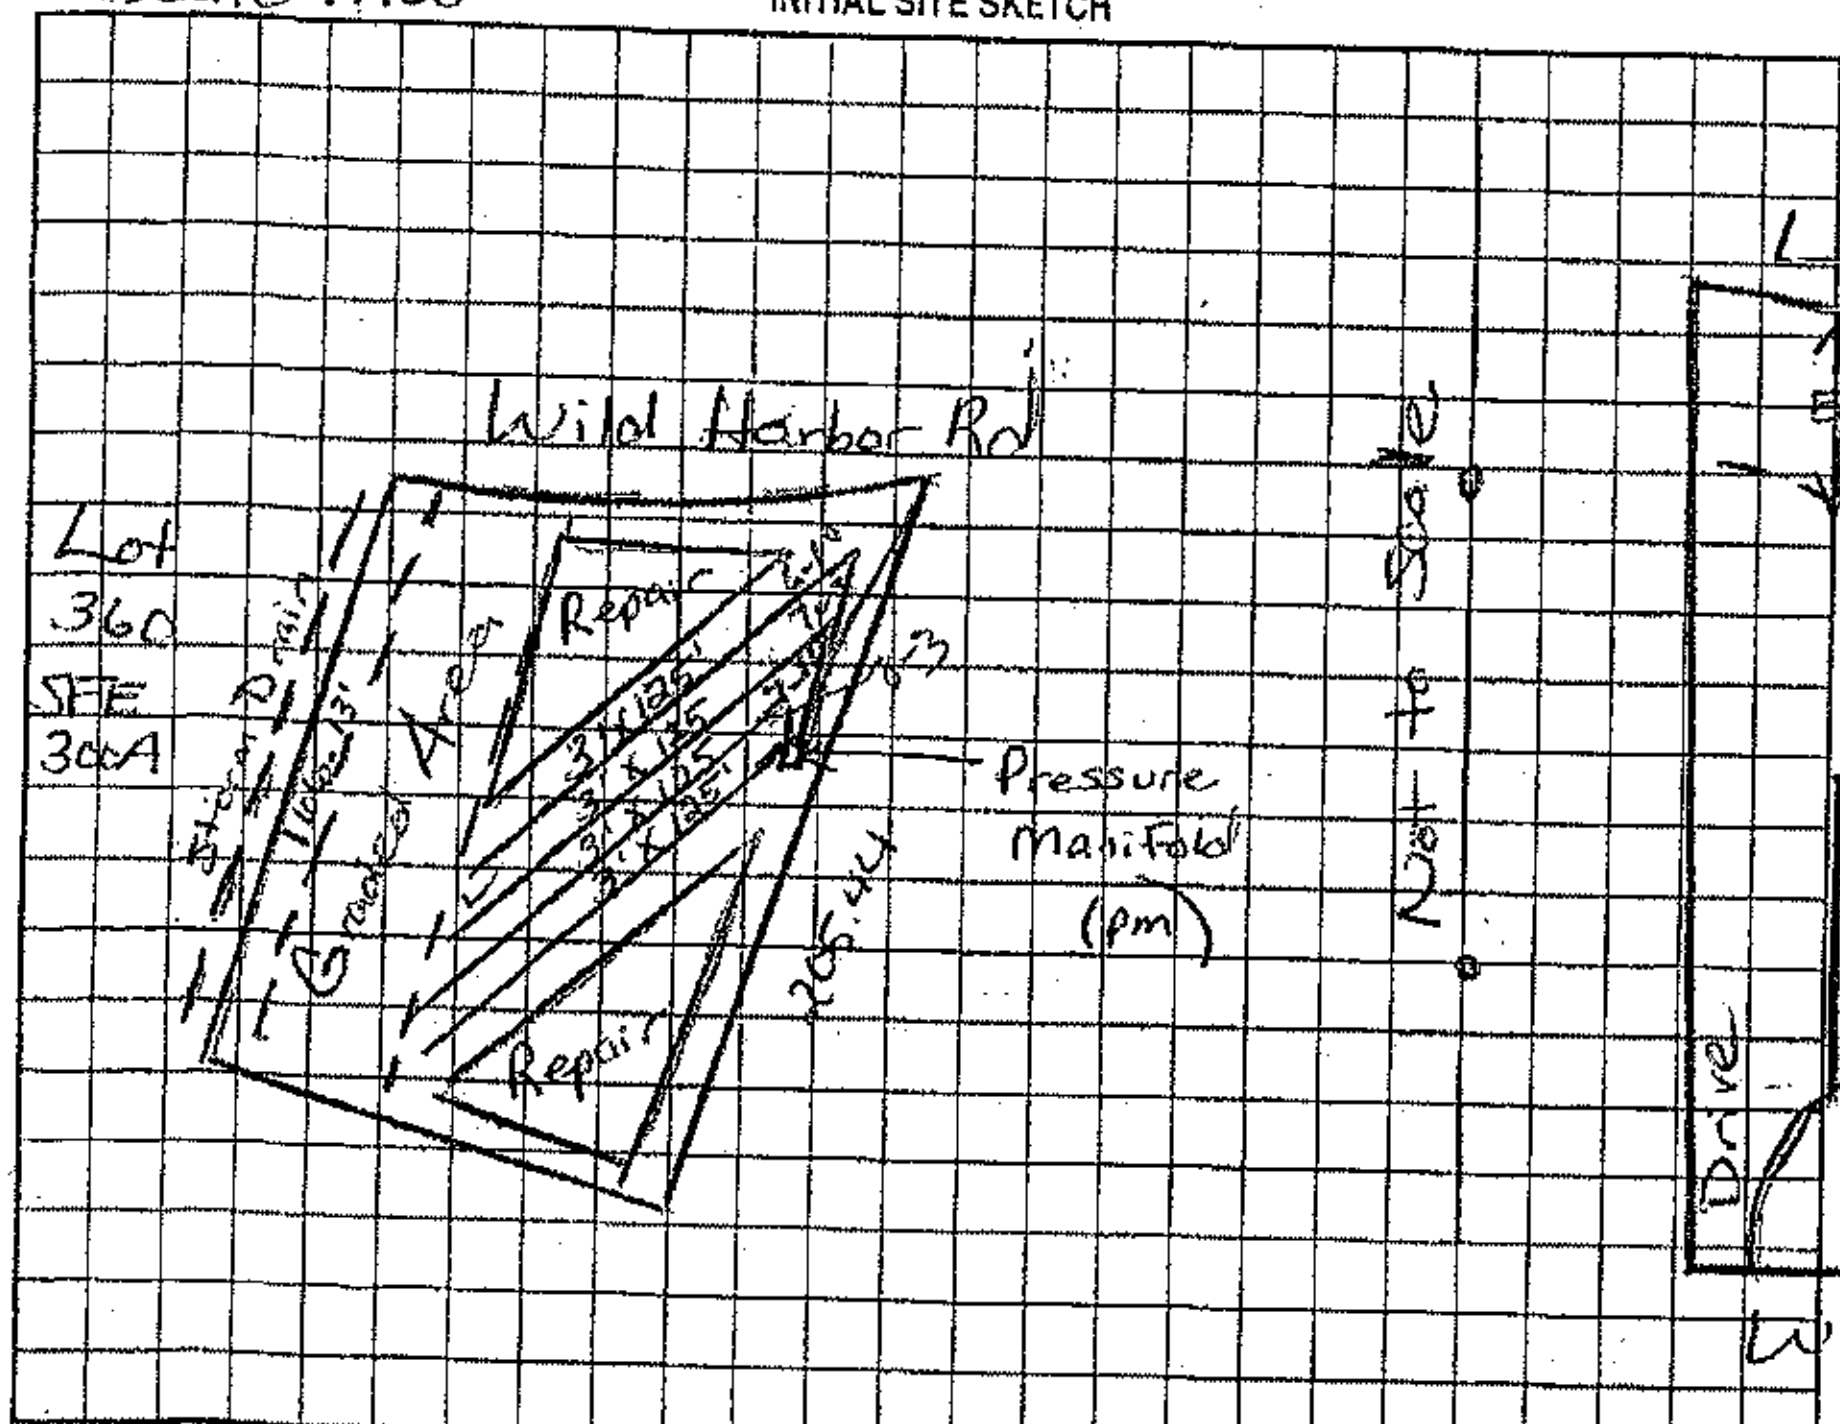

AS BUILT SKETCH

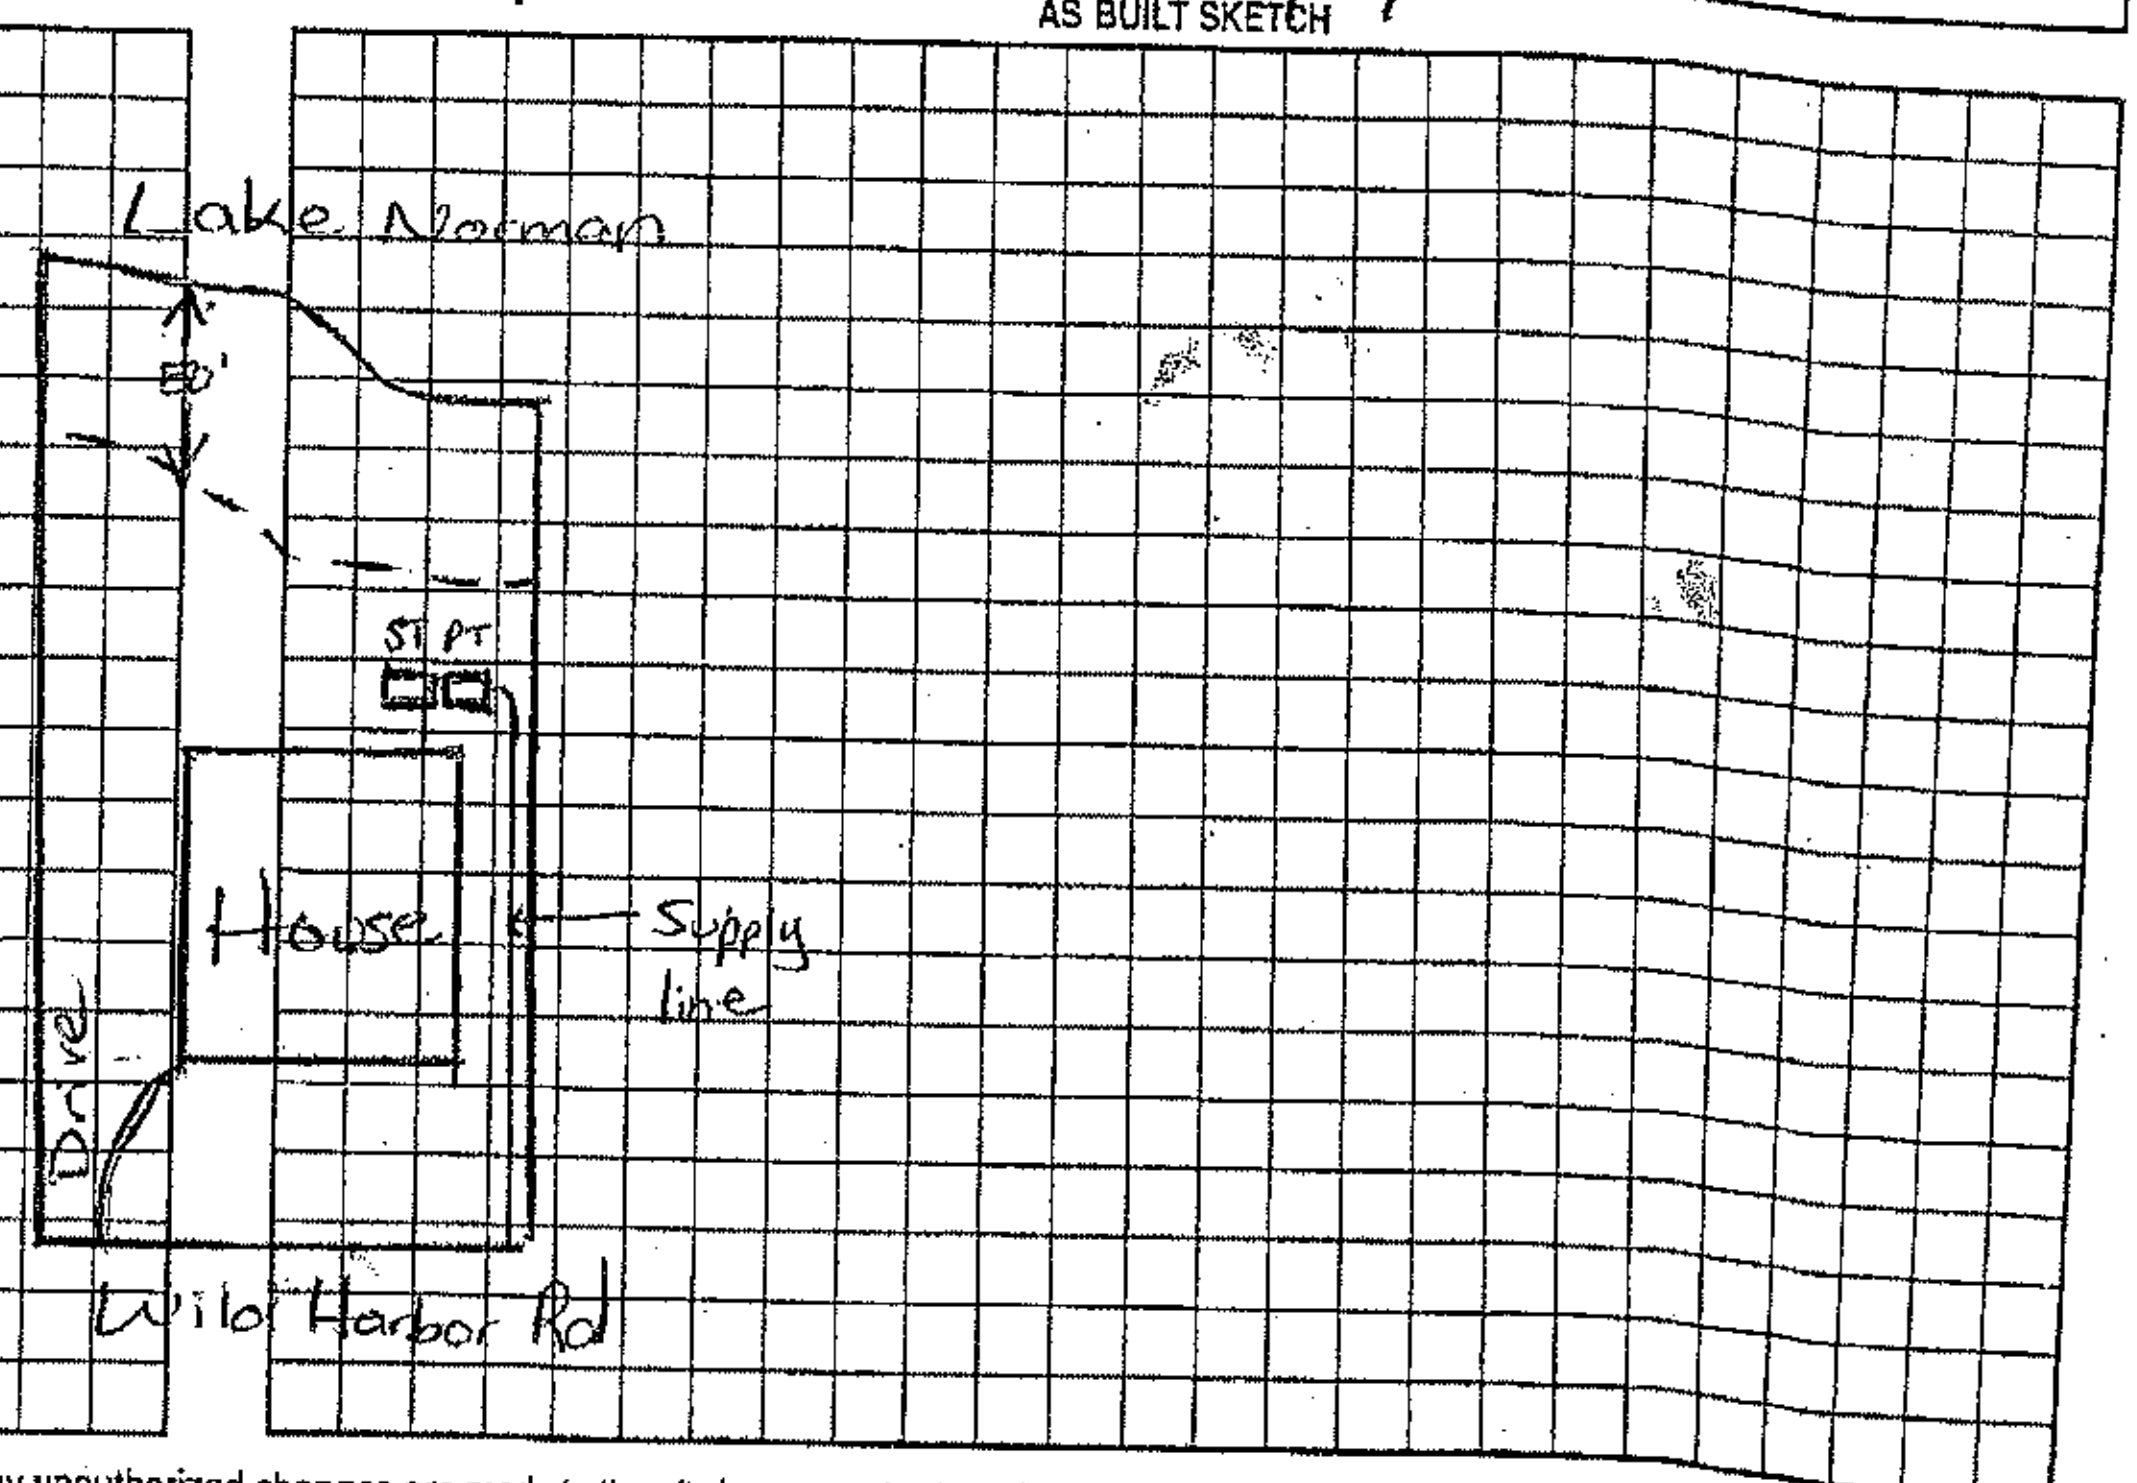

Permit can be suspended or revoked if any false information is supplied toward securing the permit/any unauthorized changes are made to the site/any unauthorized changes are made in the installation of the system. Improvement Permit with plat valid without expiration. Improvement Permit with site plan valid for sixty months. Authorization to Construct is valid for a period equal to that of Improvement Permit – not to exceed sixty months.

Signed: [signature] date 9/10/04 Installed by: R + H

Improvement Permit by: Maria H. Dobson R.S. date 8/25/04 Operation Permit by: [signature] RS date 9/16/05

Authorization to Construct by: Maria H. Dobson RS date 8/25/04 Existing System Inspection by: ______ date ______

HEALTH DEPT. COPY: WHITE OWNER COPY (FINAL): YELLOW OWNER COPY (INITIAL): PINK