IREDELL COUNTY HEALTH DEPARTMENT

Statesville Office (704) 878-5305 Mooresville Office (704) 660-3625 PERMIT # 202287

IMPROVEMENT PERMIT / AUTHORIZATION TO CONSTRUCT / OPERATION PERMIT / EXISTING SYSTEM

PIN # 4626-90-2580

APPLICANT: Cottenwood Custom Homes APPLICANT ADDRESS: PO Box 2022 Cornelius, NC 28031

SITE ADDRESS: 110 Wild Harbor ~~Drive~~ Rd. PHONE: ALT. PHONE: (704) 578-4951 Kathleen Saunders

SITE DIRECTIONS: Go Brawley Sch Rd TL (into Aberdeen at) on Great Point Ct the Point sign and fountain) TL on Wild Harbor 1st on right


SUBDIVISION: The Point on Norman SECTION: 3 LOT # 295 LOT AREA: DESIGN FLOW: 480 L.T.A.R.: .3

Septic Tank	~~1000~~ 1500 (gal)	STB	1444	Date	2-11-15	☑ New System ☐ Repair ☐ Expansion	System Type: I (II) III IV V VI	☑ Residence	No. Bedrooms 4	Water Supply
Pump Tank	(gal)	PT		Date		System Description: 25% reduction		☐ Business	No. Persons	☐ Private
Pump Make		Model		Serial #		Repair System Description: LPP distrib panel blocked @ .275		☐ Other	No. Employees	☐ Public
# Nitrification Fields	1	# Lines	8	Linear Ft:	400	Maintenance Agreement Required:	☐ YES ☑ NO	☐ Slab	☑ Crawl Space	☑ Community
Trench Width	36"	Max. Trench Bottom Depth	36"	Gravel Depth	N/A chamber	☑ GRAVITY	☐ PRESSURE	☐ Basement w/plumbing	☐ Basement w/o plumbing	

Comments / Conditions: Maintain min. 5' from bldg, 15 from pool, 10' from property lines

* Used multi pipe instead of "Drop boxes" Used Quick 4 for Drainfield

INITIAL SITE SKETCH

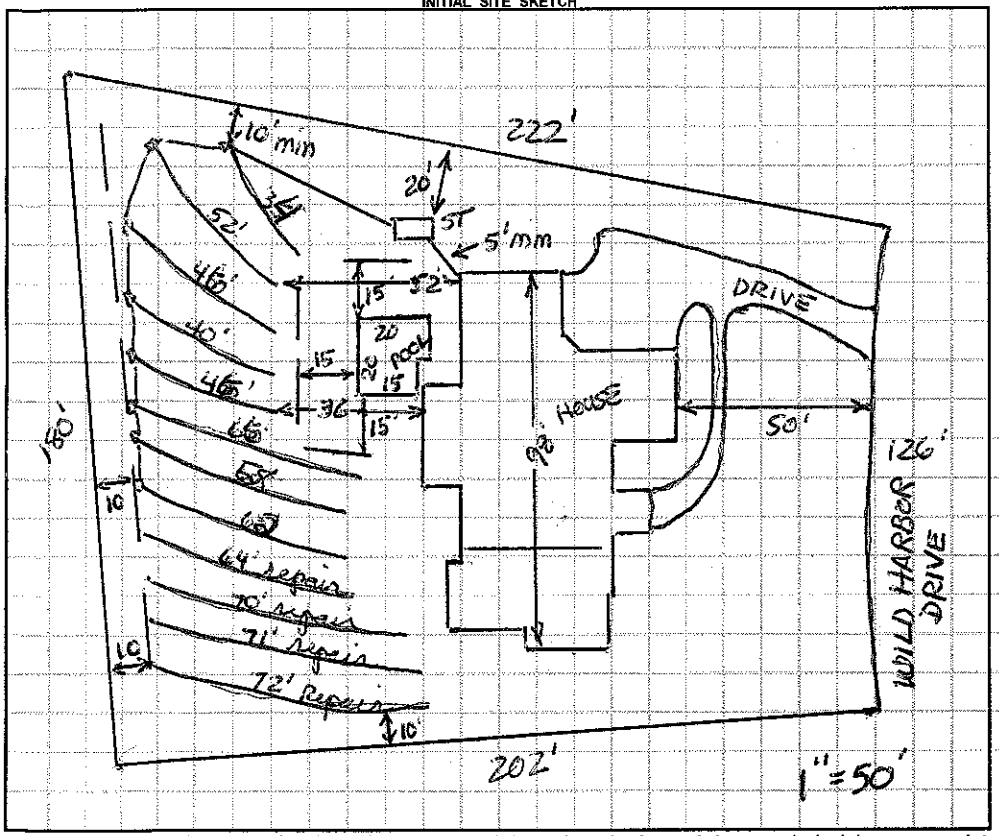

AS BUILT SKETCH

Permit can be suspended or revoked if any false information is supplied toward securing the permit / any unauthorized changes are made to the site / any unauthorized changes are made in the installation of the system. **CONTACT A LOCATOR SERVICE PRIOR TO ANY EXCAVATION**

☐ **IMPROVEMENT PERMIT** *with plat valid without expiration.* ☑ **IMPROVEMENT PERMIT** *with site plan valid for 60 mos.* ☑ **AUTHORIZATION TO CONSTRUCT** *valid for period equal to IMPROVEMENT PERMIT--not to exceed 60 mo.*

Owner / Applicant Signature: Kathleen Saunders Date: 11-24-14 Installed by: K & H Dalton RS

IMPROVEMENT PERMIT by: Richard Farris Date: 11/18/14 OPERATION PERMIT by: Marcus Dalton Date: 3/18/15

AUTHORIZATION TO CONSTRUCT by: Richard Farris Date: 11/18/14 Existing System Inspected by: Date:

Health Dept. Copy - WHITE Applicant (Final Approval) - YELLOW Applicant (Conditional Approval) - PINK