IREDELL COUNTY HEALTH DEPARTMENT

Statesville Office (704) 878-5305 Mooresville Office (704) 660-3625 PERMIT # 180304

IMPROVEMENT PERMIT / AUTHORIZATION TO CONSTRUCT / OPERATION PERMIT / EXISTING SYSTEM

PIN # 4626903087

APPLICANT: Robert Holman/Stonebridge APPLICANT ADDRESS: P.O. Box 4297 Mooresville, NC 28117

SITE ADDRESS: 156 Great Point Dr. Mooresville, NC PHONE: ALT. PHONE: Ron 704 400-1235

SITE DIRECTIONS: Brawley School Rd TL Great Point Dr on right


SUBDIVISION: The Point SECTION: 3 LOT # 279 LOT AREA: 1.927 Acre DESIGN FLOW: 480 gpd L.T.A.R.: .267

Septic Tank: Amin 1000 (gal)	STB 2331500	Date 12/5/14	☒ New System ☐ Repair ☐ Expansion	System Type: I II III IV V VI	☒ Residence	No. Bedrooms 4	Water Supply
Pump Tank 1000 (gal)	PT 4771500	Date 11/17/14	System Description: Pump-LP-PPBPS		☐ Business	No. Persons	☐ Private
Pump Make Orenco Model PF1005II	Serial # F30071		Repair System Description: LPPPBPS		☐ Other	No. Employees	☐ Public
# Nitrification Fields 1 # Lines 4	Linear Ft: 304		Maintenance Agreement Required: ☒ YES ☐ NO		☐ Slab	☐ Crawl Space	☒ Community
Trench Width min. 24" Max. Trench Bottom Depth: A. 36"	Gravel Depth N/A		☐ GRAVITY ☒ PRESSURE		☒ Basement w/plumbing		☐ Basement w/o plumbing


Comments / Conditions: A Refer to Crescent Communities On Site Sewage Construction Guidelines for ST Size & trench width

Keep Septic a minimum 10ft to PL. No vehicular traffic over Septic System. Keep ST/PT 15ft from any Cut 2ft or more. 5/32" hole

INITIAL SITE SKETCH

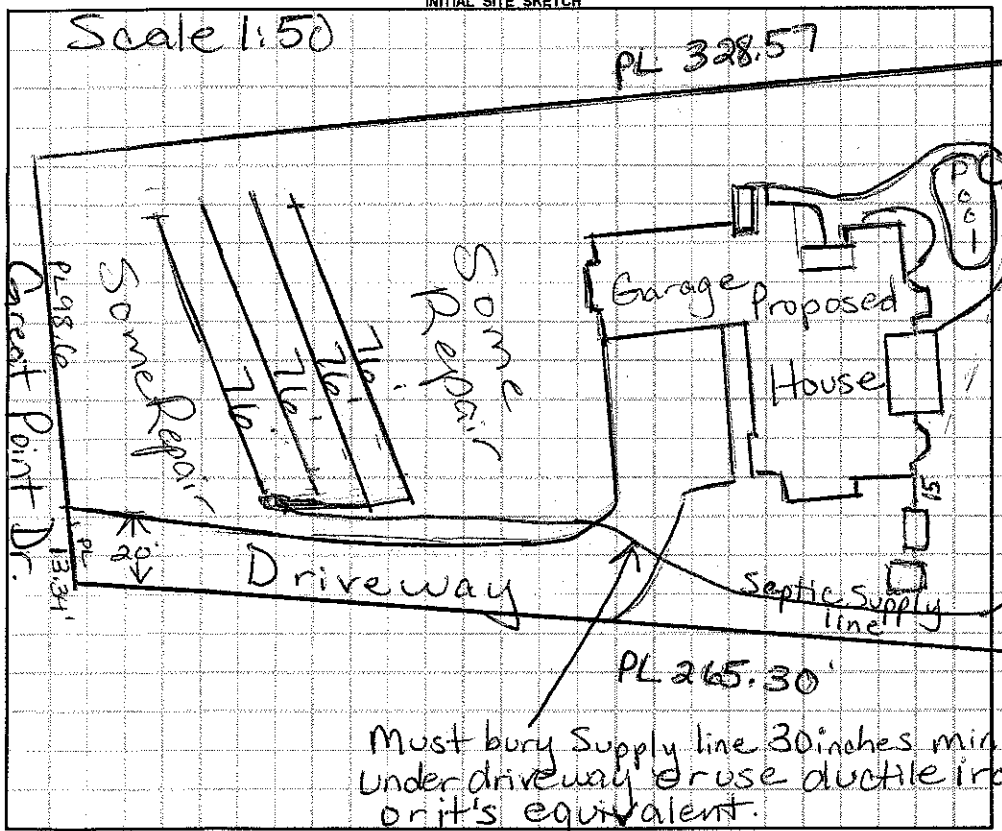

AS BUILT SKETCH

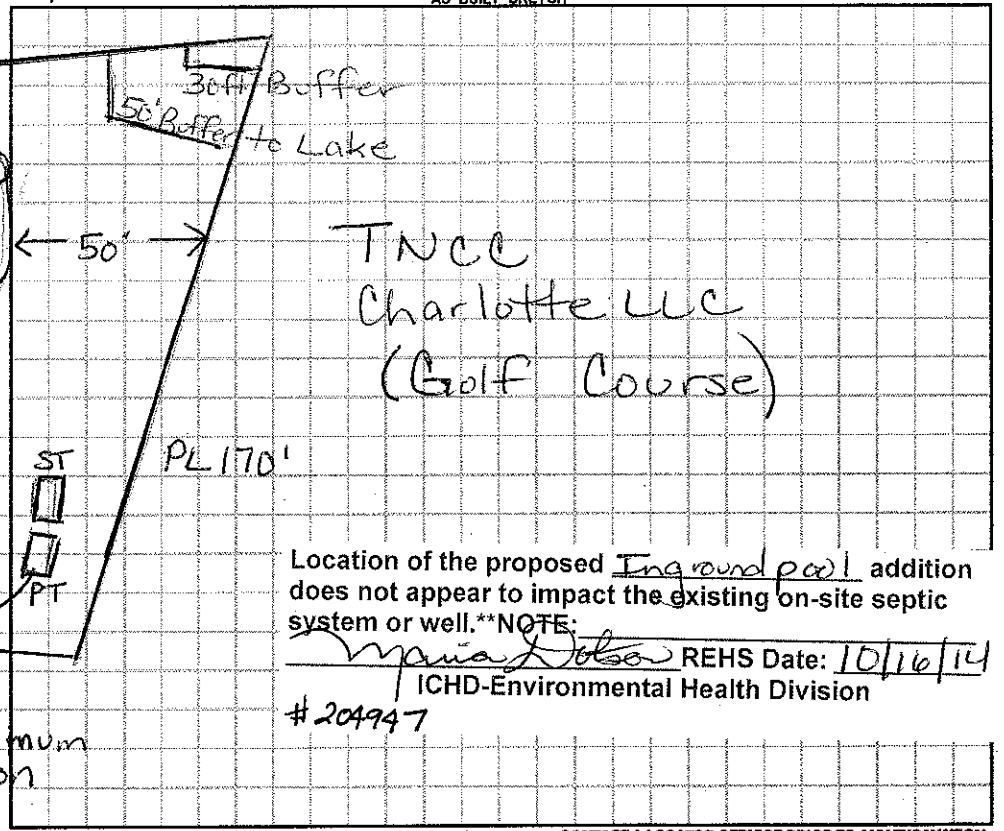

Permit can be suspended or revoked if any false information is supplied toward securing the permit / any unauthorized changes are made to the site / any unauthorized changes are made in the installation of the system. **CONTACT A LOCATOR SERVICE PRIOR TO ANY EXCAVATION**

☐ **IMPROVEMENT PERMIT** *with plat valid without expiration.* ☐ **IMPROVEMENT PERMIT** *with site plan valid for 60 mos.* ☐ **AUTHORIZATION TO CONSTRUCT** *valid for period equal to IMPROVEMENT PERMIT--not to exceed 60 mo.*

Owner / Applicant Signature: Date: 10-20-14 Installed by: Piedmont Backhoe

IMPROVEMENT PERMIT by: Maria Tolson RS Date: 10/16/14 OPERATION PERMIT by: Maria Tolson RS Date: 2/5/15

AUTHORIZATION TO CONSTRUCT by: Maria Tolson RS Date: 10/16/14 Existing System Inspected by: Date:

Health Dept. Copy - WHITE Applicant (Final Approval) - YELLOW Applicant (Conditional Approval) - PINK