IREDELL COUNTY HEALTH DEPARTMENT

STATESVILLE 704-878-5305 MOORESVILLE 704-664-5281

IMPROVEMENT PERMIT / AUTHORIZATION TO CONSTRUCT / OPERATION PERMIT / EXISTING SYSTEM INSPECTION

(I-30)

PERMIT# 78377 PIN# 4625-97-6884 (PT) 4626-90-4682

OWNER OR CONTRACTOR CARDINAL RESOURCES

ADDRESS 324 BRAWLEY SCHOOL RD - MOORESVILLE PHONE: Business 660-1185 Home

DATE 9/13/99

LOCATION BRAWLEY SCHOOL RD. - TL GREAT POINT DR. - TL WALKING LN. AT END OF LT

SUBDIVISION POINT BLOCK / SECTION II LOT 291 LOT AREA 35,235 SF SITE CLASS PS DESIGN FLOW 360 L.T.A.R. .3

Septic Tank: Ideal 1500 Gallons: STB 794 Date 9/2/00

Pump Tank: 1000 Gallons: PT 2853 Date 9/2/00

Pump Make: MESF Model MYED3 Serial No.

Nitrification Field: No Fields 1 Square Feet 600 Linear Feet 300

No Lines 6@50' Trench Width 36" Max Trench Bottom Depth 36" Gravel Depth N/A

☑ New System ☐ Repair System Type: I, II, III, IV, V, VI

System Description: PUMP PANEL

Repair System Description: SAME

Maintenance Agreement Required: ☑ Yes ☐ No

☑ House/Mod. Home ☐ Mobile Home ☐ Business ☐ Other

No. Bedrooms 4 No. Bathrooms 4 No. Employees


Water Supply: ☐ Individual ☐ Public ☐ Community

☐ Slab ☐ Crawl Space ☐ Basement w/plumbing ☐ Basement w/o plumbing


Comments/Conditions:

Comments/Conditions:

INITIAL SITE SKETCH

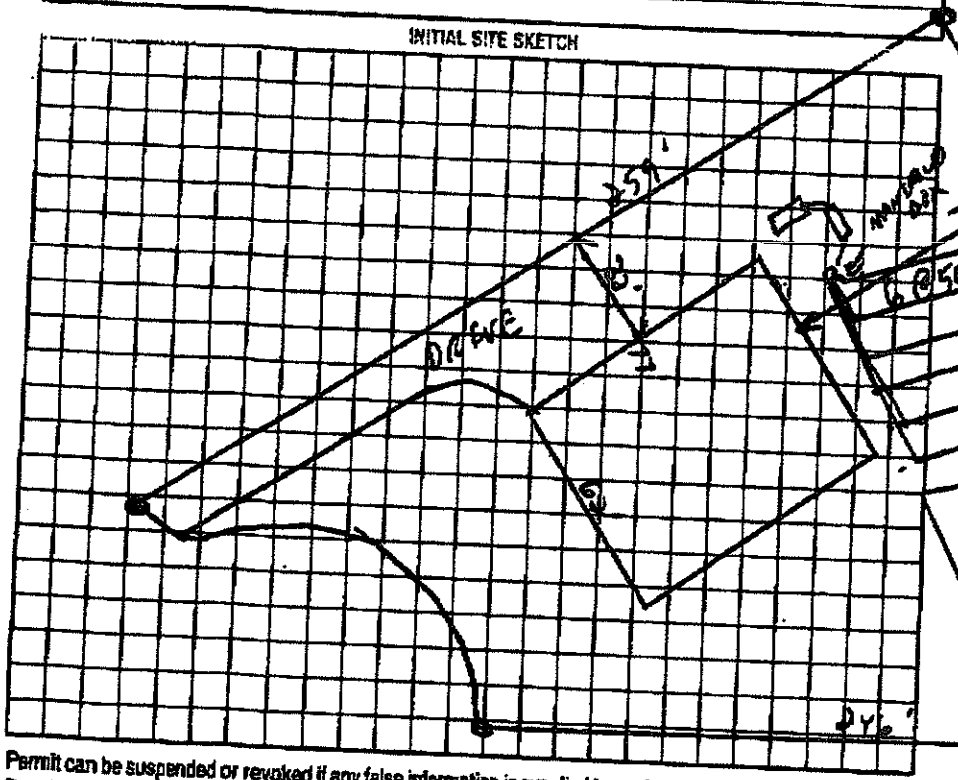

AS BUILT SKETCH

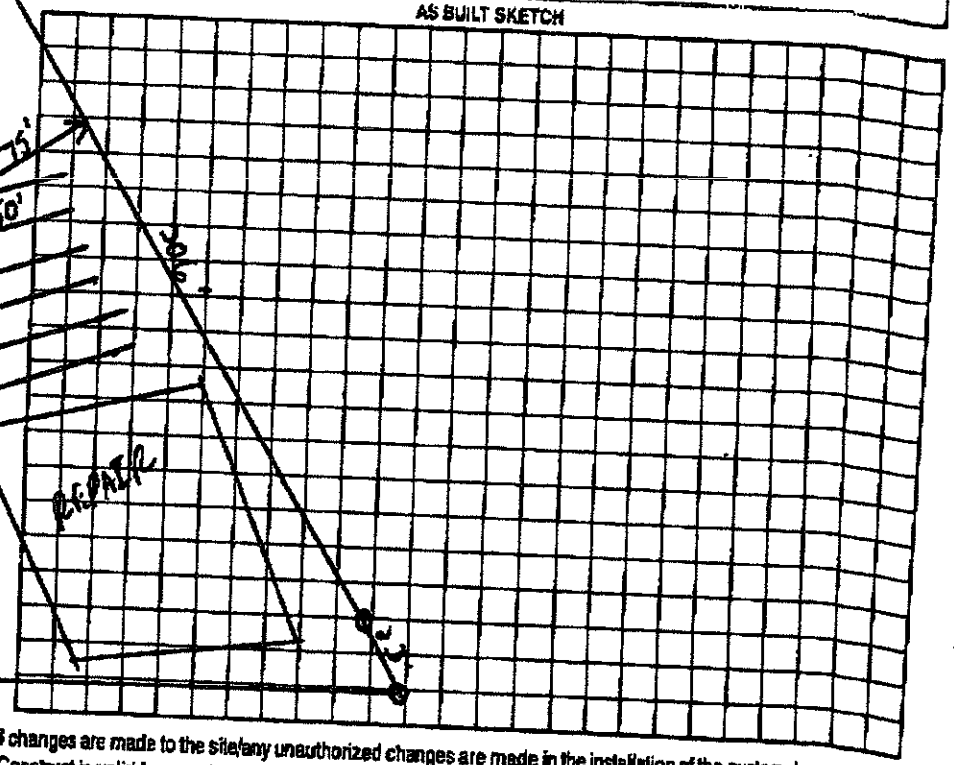

Permit can be suspended or revoked if any false information is supplied toward securing the permit/any unauthorized changes are made to the site/any unauthorized changes are made in the installation of the system. Improvement Permit with plat valid without expiration. Improvement Permit with site plan valid for sixty months. Authorization to Construct is valid for a period equal to that of Improvement Permit – not to exceed sixty months.

Signed: Carolyn Spellenberg date 9-13-99

Improvement Permit by: C. [illegible] RS date 9/13/99

Authorization to Construct by: C. [illegible] RS date 9/13/99

Installed by: R & H Construction

Operation Permit by: [illegible] RS date 8/7/2000

Existing System Inspection by: date

HEALTH DEPT. COPY: WHITE OWNER COPY (FINAL): YELLOW OWNER COPY (INITIAL): PINK

PAGE 01

03/04/2010 15:25 7046623239