IREDELL COUNTY HEALTH DEPARTMENT

STATESVILLE 704-878-5305 MOORESVILLE 704-664-5281

IMPROVEMENT PERMIT / AUTHORIZATION TO CONSTRUCT / OPERATION PERMIT / EXISTING SYSTEM INSPECTION

125 2:00

PERMIT# 03362 11882 PIN# 4625944684(pt) Tom Stevenson 4626905017 DATE May 3, 99

OWNER OR CONTRACTOR Crescent Resources c/o The Point at Rosemont PHONE: Business 660-1195 Home

ADDRESS 2214 Brawley Sch Rd. Mooresville

LOCATION Brawley Sch Rd. To Great Point Dr. on Right near end

SUBDIVISION The Point BLOCK / SECTION III LOT 280 LOT AREA 45702 sf SITE CLASS RS DESIGN FLOW 480gpd L.T.A.R. no3

Septic Tank: 1080 gal Gallons; STB Date

Pump Tank: 1000 Gallons; PT Date

Pump Make: Model Serial No.

Nitrification Field: No Fields 1 Square Feet 1350 Linear Feet 450

No Lines 5@90' Trench Width 36" Max Trench Bottom Depth 36" Gravel Depth N/A

☑ New System ☐ Repair System Type: I, II, III, IV, V, VI

System Description: PM - Innovative 25% Reduction

Repair System Description: SAME

Maintenance Agreement Required: ☐ Yes ☑ No

☑ House/Mod. Home No. Bedrooms 4

☐ Mobile Home No. Bathrooms 4

☐ Business No. Employees

☐ Other


☑ Slab ☑ Crawl Space ☐ Basement w/plumbing ☐ Basement wo/plumbing

Water Supply: ☐ Individual ☑ Public ☐ Community


Comments/Conditions: * ONE INSPECTION COST PER LOT/ITEM.
9-3-03 House & site plan substantially in compliance. OK to install driveway along right side line and run WW supply line up left side

Comments/Conditions: (PARTIAL) Lines checked 6/4/04 MD
WATER & Utility LINES

1"=50' INITIAL SITE SKETCH

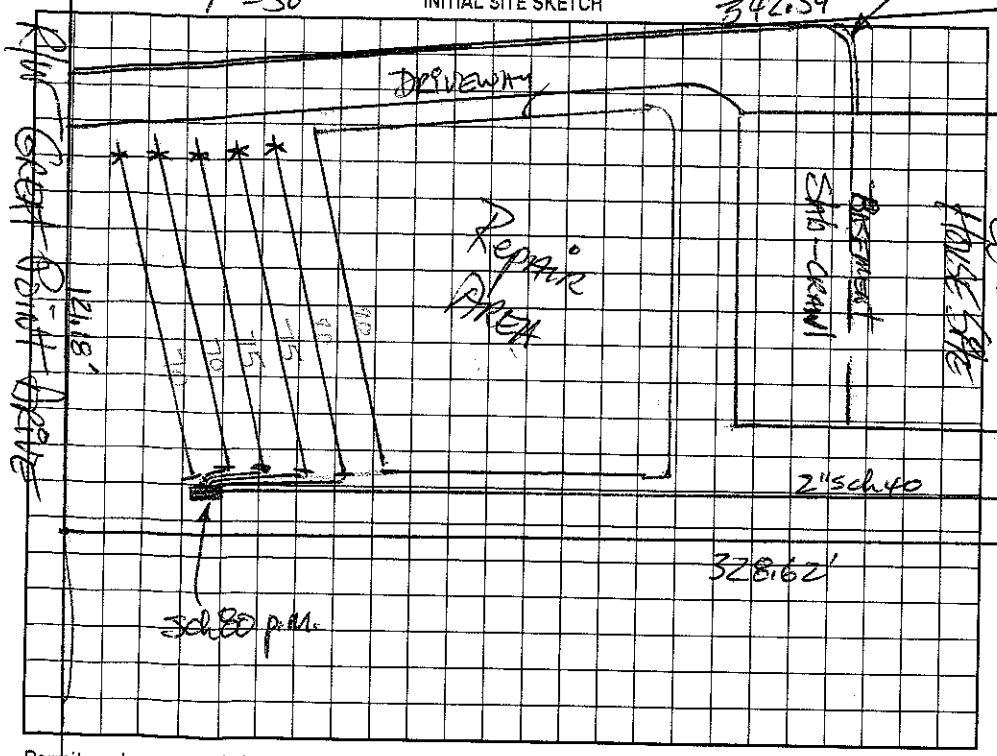

AS BUILT SKETCH

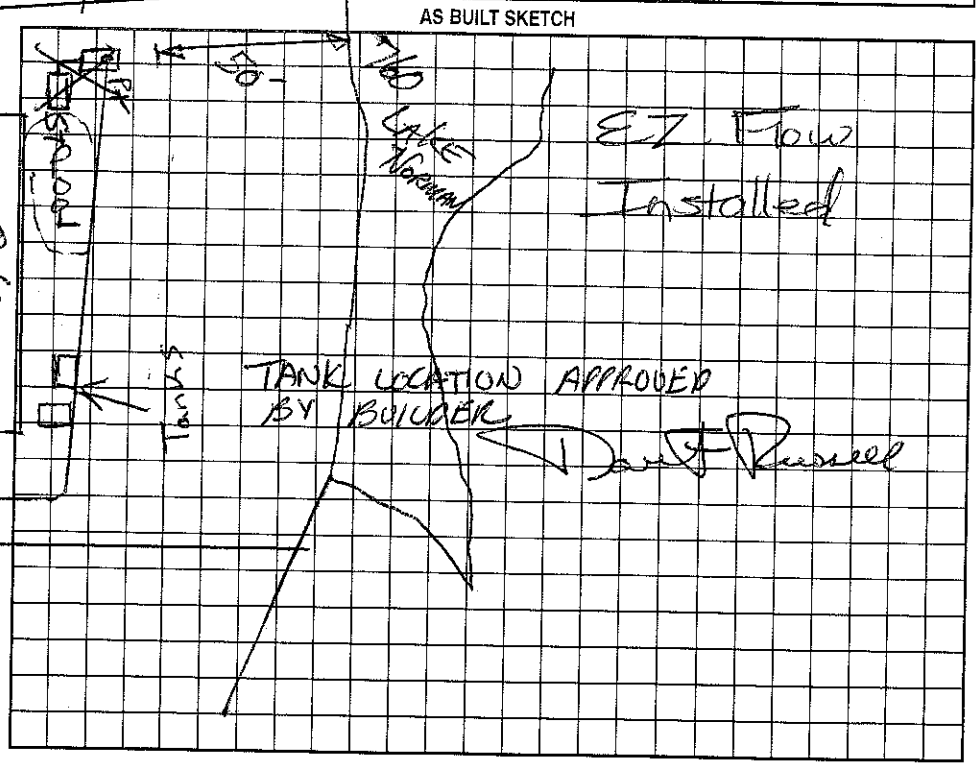

Permit can be suspended or revoked if any false information is supplied toward securing the permit/any unauthorized changes are made to the site/any unauthorized changes are made in the installation of the system. Improvement Permit with plat valid without expiration. Improvement Permit with site plan valid for sixty months. Authorization to Construct is valid for a period equal to that of Improvement Permit – not to exceed sixty months.

Signed: date 5-14-99

Improvement Permit by: date 5-3-99

Authorization to Construct by: date 9-3-03

Installed by:

Operation Permit by: date 6/23/04

Existing System Inspection by: date

HEALTH DEPT. COPY: WHITE OWNER COPY (FINAL): YELLOW OWNER COPY (INITIAL): PINK