IREDELL COUNTY HEALTH DEPARTMENT

STATESVILLE 704-878-5305 MOORESVILLE 704-664-5281

IMPROVEMENT PERMIT / AUTHORIZATION TO CONSTRUCT / OPERATION PERMIT / EXISTING SYSTEM INSPECTI

PERMIT# 078338 PIN# 4625944684 (pt.) 4620-90-5469 DATE May 4 '99

OWNER OR CONTRACTOR Crescent Resources LLC / The Point c/o Ackerman PHONE: Business 660-1165 Home

ADDRESS 2214 Brawley Sch Rd Mooresville

LOCATION Brawley Sch Rd TL Great Point Dr. TL Whaling Lane on left near end

SUBDIVISION The Point BLOCK / SECTION III LOT 292 LOT AREA 34,464 sf SITE CLASS PS DESIGN FLOW 480 gpd L.T.A.R. .3

Septic Tank: 1000 Gallons; STB 338 Date 10-14-00

Pump Tank: Gallons; PT Date

Pump Make: Model Serial No.

Nitrification Field: No Fields 1 Square Feet 1200 Linear Feet 400

No Lines 4@100' Trench Width 36" Max Trench Bottom Depth 36" Gravel Depth NA

☑ New System ☐ Repair System Type: I, II, III, IV, V, VI

System Description: GRAVITY INNOVATIVE / 25% Red. LP Pave / Block.

Repair System Description:

Maintenance Agreement Required: ☐ Yes ☑ No INITIALLY

☑ House/Mod. Home No. Bedrooms 4

☐ Mobile Home No. Bathrooms 4

☐ Business No. Employees

☐ Other

☐ Slab ☑ Crawl Space ☐ Basement w/plumbing ☐ Basement wo/plumbing

Water Supply: ☐ Individual ~~☐ Public~~ ☑ Community


Comments:/Conditions: *ONE INSPECTION PORT PER CATEGORY

5-24 Received house & site plan; appears in compliance w/ I.P.

12-4-00 Upper 2 LINES CAN be up to 48" trench bottom depth. DMH

Comments:/Conditions: Polylok Fitter installed & riser. 12/11/2000 Checked lower 2 lines Fo.

1"=50' INITIAL SITE SKETCH Revisit by Paul Pennington of TC Jacobs & Assoc. indicates sufficient soil depth to go 48" trench bottom. AS BUILT SKETCH

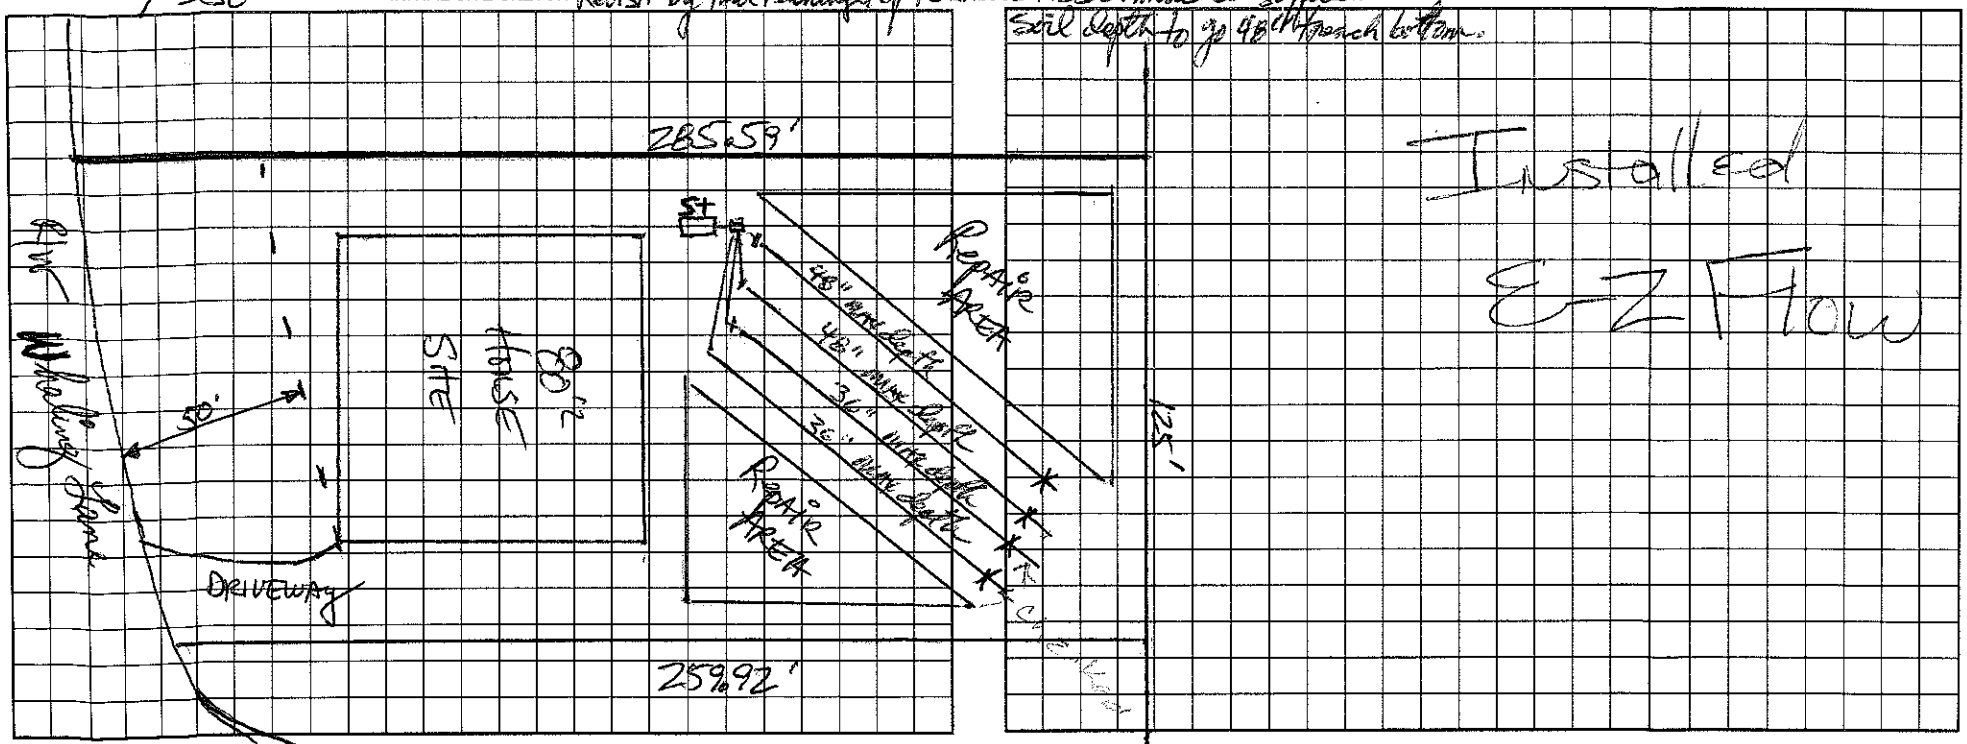

Permit can be suspended or revoked if any false information is supplied toward securing the permit/any unauthorized changes are made to the site/any unauthorized changes are made in the installation of the system. Improvement Permit with plat valid without expiration. Improvement Permit with site plan valid for sixty months. Authorization to Construct is valid for a period equal to that of Improvement Permit – not to exceed sixty months.

Signed: Karl C. Pace date 5-18-99 Installed by: R&H

Improvement Permit by: date 5-4-99 Operation Permit by: Mark Hall Watson RS date 12/13/2000

Authorization to Construct by: date 5-24-00 Existing System Inspection by: date

HEALTH DEPT. COPY: WHITE OWNER COPY (FINAL): YELLOW OWNER COPY (INITIAL): PINK