IREDELL COUNTY HEALTH DEPARTMENT

STATESVILLE 704-878-5305 50.00 Paid MOORESVILLE 704-664-5281

IMPROVEMENT PERMIT / AUTHORIZATION TO CONSTRUCT / OPERATION PERMIT / EXISTING SYSTEM INSPECTION

PERMIT# 17645 PIN# 4626 90 8263 DATE 3/22/05

OWNER OR CONTRACTOR Eldred Custom Homes PHONE: Business 704-987-5022 Home

ADDRESS 16405-C Northcross Dr. Huntersville, NC 28078

LOCATION 1100 TL Great Point ct end 150' SETBACK on (R) off cul de sac

SUBDIVISION Point BLOCK / SECTION 3 LOT 50 LOT AREA 48,290 FT² SITE CLASS. PS DESIGN FLOW 480 L.T.A.R. .3

Septic Tank: 1500 Gallons; STB 338 Date 4/3/06

Pump Tank: 1500 Gallons; PT 477 Date 3/18/06

Pump Make: Gorman Rupp Model WSO-712/HBA Serial No. 3/9/06

Nitrification Field: No Fields 1 Square Feet 900 Linear Feet 300

No Lines 3@100' Trench Width 3' Max Trench Bottom Depth 3' Gravel Depth N/A

[X] New System [ ] Repair System Type: I, II, III, IV, V, VI

System Description: Pressed - 16" PPBPS

Repair System Description: SAME

Maintenance Agreement Required: [ ] Yes [ ] No

[X] House/Mod. Home No. Bedrooms 4

[ ] Mobile Home No. Bathrooms 4

[ ] Business No. Employees

[ ] Other


[ ] Slab [ ] Crawl Space [X] Basement w/plumbing [ ] Basement w/o plumbing

Water Supply: [ ] Individual [ ] Public [X] Community POINT


Comments:/Conditions:

Install Lesshan on AC.

INITIAL SITE SKETCH

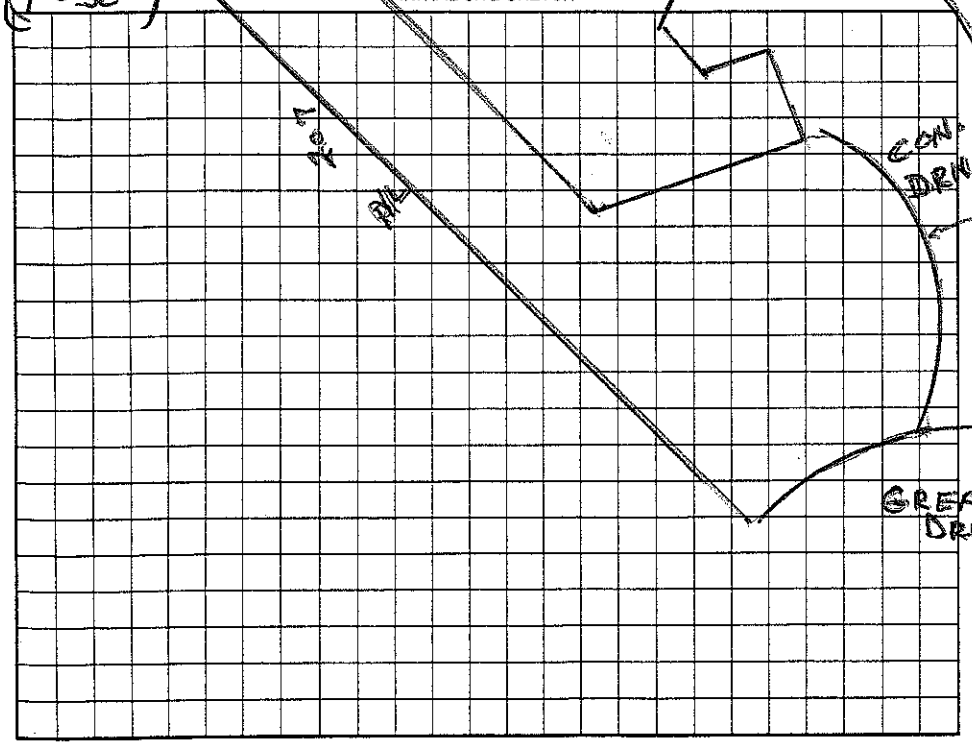

AS BUILT SKETCH

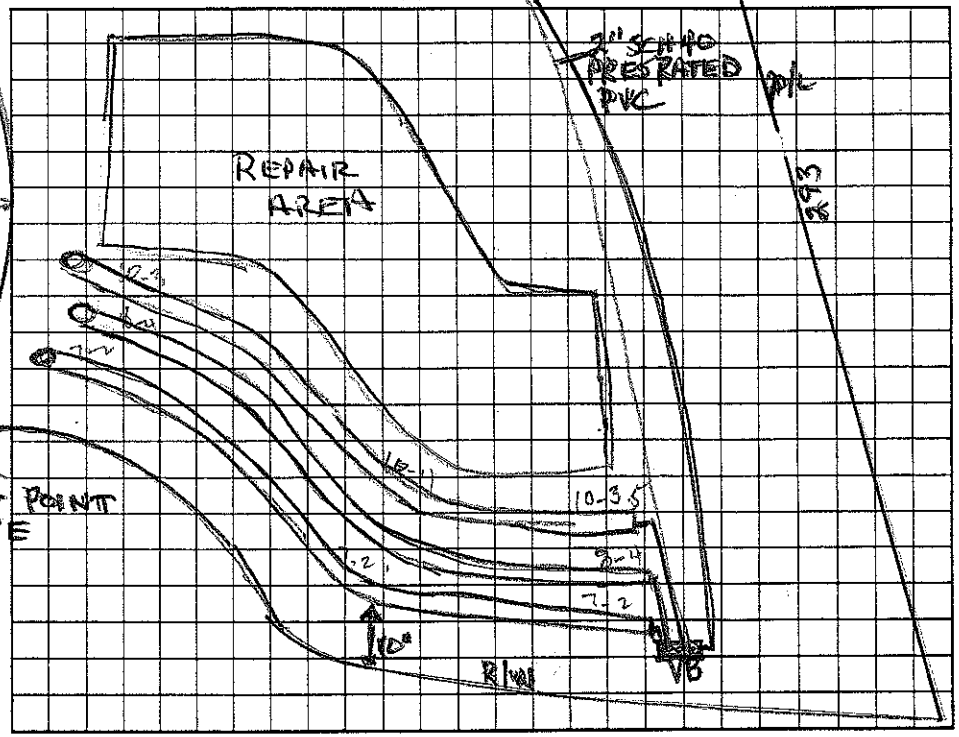

Permit can be suspended or revoked if any false information is supplied toward securing the permit/any unauthorized changes are made to the site/any unauthorized changes are made in the installation of the system. Improvement Permit with plat valid without expiration. Improvement Permit with site plan valid for sixty months. Authorization to Construct is valid for a period equal to that of Improvement Permit – not to exceed sixty months.

Signed: X date 4-5-05

Improvement Permit by: Wesley Sparks R.S. date 3/22/05

Authorization to Construct by: Wesley Sparks R.S. date 3/22/05

Installed by: Orbison & Sons

Operation Permit by: Wesley Sparks R.S. date 6/19/06

Existing System Inspection by: date

HEALTH DEPT. COPY: WHITE OWNER COPY (FINAL): YELLOW OWNER COPY (INITIAL): PINK