IREDELL COUNTY HEALTH DEPARTMENT

Paid 50.00 2:00

STATESVILLE 704-878-5305 MOORESVILLE 704-664-52

IMPROVEMENT PERMIT / AUTHORIZATION TO CONSTRUCT / OPERATION PERMIT / EXISTING SYSTEM INSPECTION

PERMIT# 078374 PIN# ~~4625 94 1684 PL~~ 4626908632 DATE 11/29/00

OWNER OR CONTRACTOR C.R.I. / Brookshire Const. PHONE: Business 666-1185 Home

ADDRESS

LOCATION Brawley Sch Rd TL Duck Point Dr. TL Whaling Lane on Right

SUBDIVISION Point I BLOCK / SECTION III LOT 287 LOT AREA 40,255 FT² SITE CLASS PS DESIGN FLOW 480 L.T.A.R. .3

Septic Tank: 1500 Gallons; STB 338 Date 6-16-01
Pump Tank: 1000 Gallons; PT 27 Date 6-16-01
Pump Make: Model Serial No.
Nitrification Field: No Fields 1 Square Feet 1200 ± Linear Feet 400 ±
No Lines ~~4 @ 100'~~ Trench Width 3' Max Trench Bottom Depth 3'

X New System ☐ Repair System Type: I, II, (III), IV, V, VI
System Description: PM → 25% Reduction
Repair System Description: Same
Maintenance Agreement Required: X Yes ☐ No
Gravel Depth SAND.


X House/Mod. Home No. Bedrooms 4
☐ Mobile Home No. Bathrooms 4
☐ Business No. Employees
☐ Other
☐ Slab X Crawl Space ☐ Basement w/plumbing ☐ Basement wo/plumbing

Water Supply: ☐ Individual ☐ Public X Community


Comments:/Conditions: 50@80'

Comments:/Conditions: Checked lines 6/19/2001
EZ Lay installed.
Checked tanks 7/20/2001

(1" = 50') INITIAL SITE SKETCH

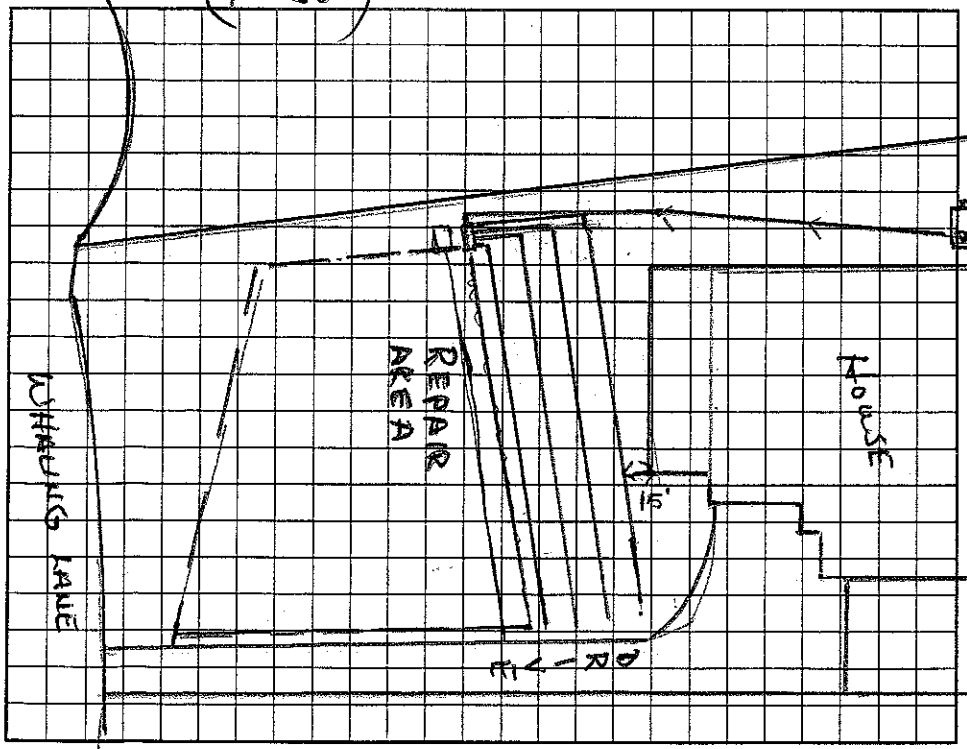

AS BUILT SKETCH

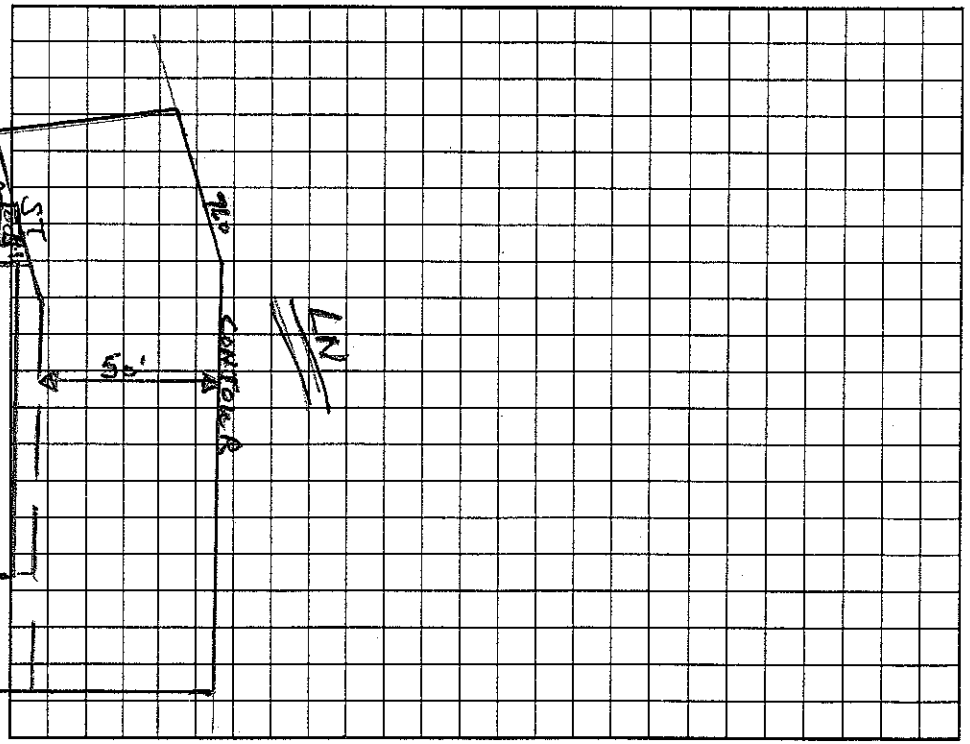

Permit can be suspended or revoked if any false information is supplied toward securing the permit/any unauthorized changes are made to the site/any unauthorized changes are made in the installation of the system. Improvement Permit with plat valid without expiration. Improvement Permit with site plan valid for sixty months. Authorization to Construct is valid for a period equal to that of Improvement Permit – not to exceed sixty months.

Signed: X [signature] date 11/29/00

Improvement Permit by: Wesley Sparks RS date 11/29/00

Authorization to Construct by: Wesley Sparks RS date 11/29/00

Installed by: R & H

Operation Permit by: Wesley Sparks RS date 11/7/01

Existing System Inspection by: date

HEALTH DEPT. COPY: WHITE OWNER COPY (FINAL): YELLOW OWNER COPY (INITIAL): PINK