IREDELL COUNTY HEALTH DEPARTMENT

STATESVILLE 704-878-5305 MOORESVILLE 704-664-5281

IMPROVEMENT PERMIT / AUTHORIZATION TO CONSTRUCT / OPERATION PERMIT / EXISTING SYSTEM INSPECTION

PERMIT# 078372 PIN# ~~4625944684 Pt~~ 4625909328 DATE 11/1/2000

OWNER OR CONTRACTOR Crescent Resources / Tom STEVENSON PHONE: Business 660-6638 Home

ADDRESS 2214 Brawley School Rd / Mooresville, NC

LOCATION Brawley School Rd TL Great Point Dr at end

SUBDIVISION The Point BLOCK / SECTION III LOT 285 LOT AREA SITE CLASS. PS DESIGN FLOW 480gpd L.T.A.R. .3

Septic Tank: 1560 Gallons; STB 338 Date 1-21-01
Pump Tank: 1000 Gallons; PT 27 Date 12-30-00
Pump Make: Model Serial No.
Nitrification Field: No Fields 1 Square Feet 1200 Linear Feet 400
No Lines 5@80' Trench Width 36" Max Trench Bottom Depth 36"

[X] New System [ ] Repair System Type: I, II, III, IV, V, VI
System Description: Pump-PM-25% Reduction*
Repair System Description: Pump - Innovative
Maintenance Agreement Required: [ ] Yes [X] No
Gravel Depth N/A [X] Slab [X] Crawl Space [X] Basement w/plumbing [ ] Basement wo/plumbing


[ ] House/Mod. Home No. Bedrooms 4
[ ] Mobile Home No. Bathrooms 5.5
[ ] Business No. Employees
[ ] Other

Water Supply: [ ] Individual [X] Public [X] Community

Comments:/Conditions: Keep Septic System at least 10' from PL & 50' From Lake

Comments:/Conditions: partial
* 25% Reduction is Drainfield area
Checked lines 12/1/2000
EZ Flow

INITIAL SITE SKETCH Scale 1:50

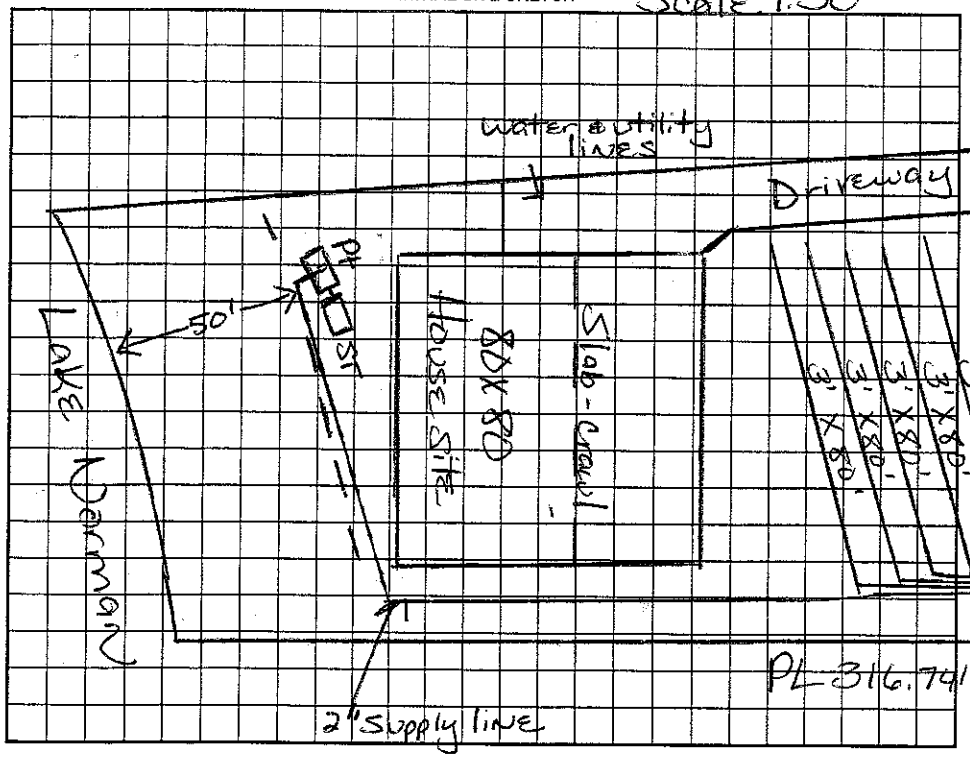

AS BUILT SKETCH Installed as Drawn

Permit can be suspended or revoked if any false information is supplied toward securing the permit/any unauthorized changes are made to the site/any unauthorized changes are made in the installation of the system. Improvement Permit with plat valid without expiration. Improvement Permit with site plan valid for sixty months. Authorization to Construct is valid for a period equal to that of Improvement Permit – not to exceed sixty months.

Signed: Jamie K. Anderson date 11/7/00 Installed by: R & H LLC

Improvement Permit by: Maria H. Dotson RS date 11/1/2000 Operation Permit by: Maria H. Dotson RS. date 5/15/2001

Authorization to Construct by: Maria H. Dotson RS date 11/1/2000 Existing System Inspection by: date

HEALTH DEPT. COPY: WHITE OWNER COPY (FINAL): YELLOW OWNER COPY (INITIAL): PINK