As Built

IREDELL COUNTY HEALTH DEPARTMENT

STATESVILLE 704-878-5305 MOORESVILLE 704-664-5281

IMPROVEMENT PERMIT / AUTHORIZATION TO CONSTRUCT / OPERATION PERMIT / EXISTING SYSTEM INSPECTION

PERMIT# 129736 PIN# 4626910393 DATE

OWNER OR APPLICANT Simonini Bld PHONE: Business Home

ADDRESS

LOCATION Brawley School Rd TL Wild Harbor TL Atlantic Way TR Breakwater Ct.

SUBDIVISION Point BLOCK / SECTION 3 LOT 321 LOT AREA 71,516 Ft2 SITE CLASS. PS DESIGN FLOW 480 gpd L.T.A.R. .25

Septic Tank: 1500 Gallons; STB 444 Date 1-31-06
Pump Tank: 1000 Gallons; PT 169 Date 7-17-05
Pump Make: Myers Model ME50 Serial No.
Nitrification Field: No fields 1 Square Feet 960 Linear Feet 320
No Lines 4@80' Trench Width 36" Max Trench Bottom Depth 36"

☐ New System ☐ Repair ☐ Expansion System Type: I II III IV V VI
System Description: Pump-LP-Panel Blk
Repair System Description: Same
Maintenance Agreement Required: ☒ Yes ☐ No

☒ House/Mod. Home No. Bedrooms 4
☐ Mobile Home No. Persons
☐ Business No. Employees
☐ Other

Water Supply: ☐ Individual ☐ Public ☒ Community


Gravel Depth N/A ☐ Gravity ☒ Pressure ☐ Slab ☐ Crawl Space ☒ Basement w/plumbing ☐ Basement wo/plumbing

Comments:/Conditions:


Comments:/Conditions:
PL 86'

Scale 1:60

INITIAL SITE SKETCH

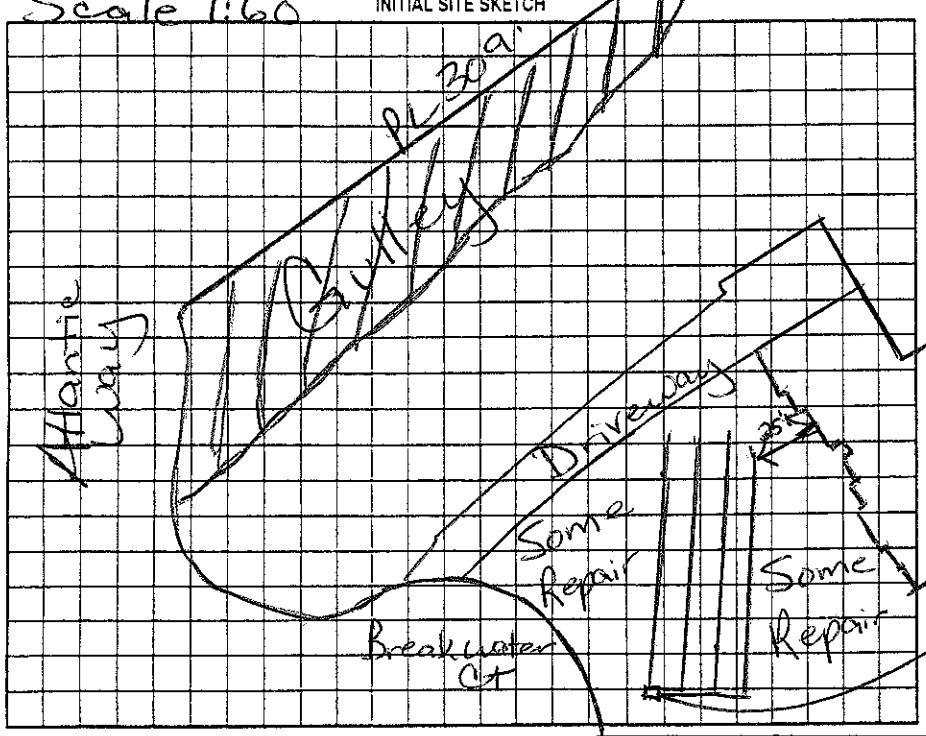

AS BUILT SKETCH

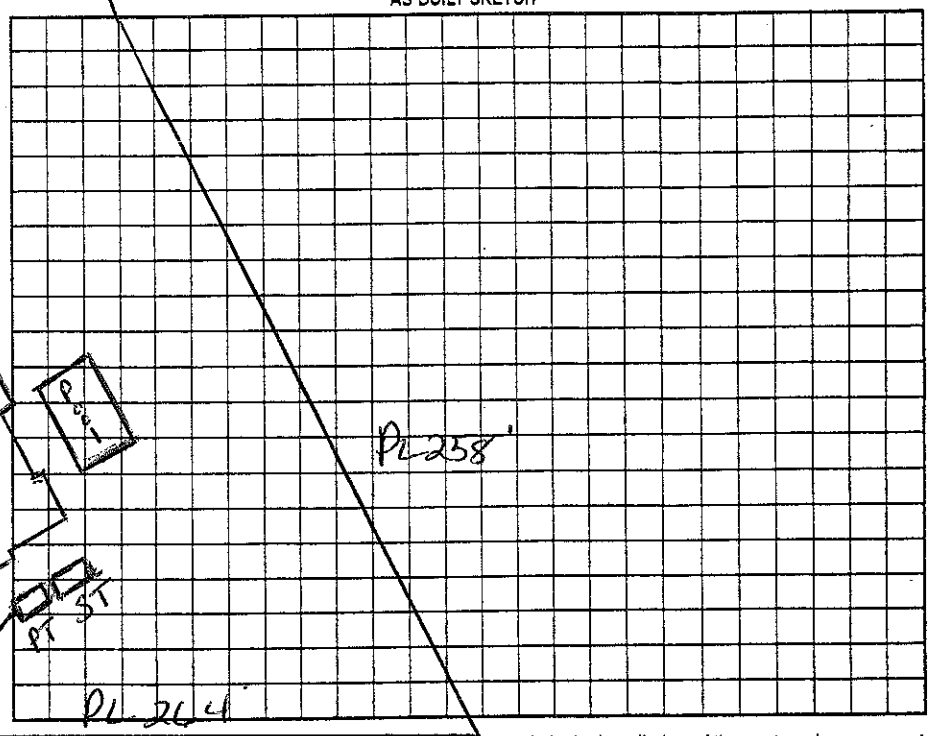

Permit can be suspended or revoked if any false information is supplied toward securing the permit/any unauthorized changes are made to the site/any unauthorized changes are made in the installation of the system. Improvement Permit with plat valid without expiration ☐ Improvement Permit with site plan valid for sixty months ☐ Authorization to Construct is valid for a period equal to that of Improvement Permit – not to exceed sixty months.

Signed: date 5/16/06

Improvement Permit by: Maina H. Dotson RS date 5/16/06

Authorization to Construct by: Maina H. Dotson RS date 5/16/06

Installed by: R&H

Operation Permit by: Maina H. Dotson RS date 5/18/06

Existing System Inspection by: date

HEALTH DEPT. COPY: WHITE OWNER COPY (FINAL): YELLOW OWNER COPY (INITIAL): PINK