IREDELL COUNTY HEALTH DEPARTMENT

STATESVILLE 704-878-5305 MOORESVILLE 704-664-5281

IMPROVEMENT PERMIT / AUTHORIZATION TO CONSTRUCT / OPERATION PERMIT / EXISTING SYSTEM INSPECTION

2180

PERMIT# 078524/129736 PIN# 4625-94-1684 pt 4626910393 DATE 6/28/05

OWNER OR CONTRACTOR Simonini Bldrs PHONE: Business 704 358-9940 Home

ADDRESS 1910 South Blvd Charlotte NC

LOCATION BSR, TL Great Point TL Wild Harbor, TL Atlantic Way, TR Breakwater Ct. (105)

SUBDIVISION Point BLOCK / SECTION 3 LOT 321 LOT AREA 71,516 Ft² SITE CLASS PS DESIGN FLOW 480 L.T.A.R. 0.25

Septic Tank: 1000 Gallons; STB 7440 Date 1-31-06

Pump Tank: 1000 Gallons; PT 1609 Date 7-17-05

Pump Make: Myers Model ME50 Serial No.

Nitrification Field: No. Fields 1 Square Feet 960 Linear Feet 320

No Lines 4@80' Trench Width 36" Max Trench Bottom Depth 36" Gravel Depth —

☒ New System ☐ Repair System Type: I, II, III, IV, V, VI

System Description: LP Panel Block

Repair System Description: Same

Maintenance Agreement Required: ☒ Yes ☐ No

☒ House/Mod. Home No. Bedrooms 4

☐ Mobile Home No. Bathrooms

☐ Business No. Employees

☐ Other

☐ Slab ☐ Crawl Space ☒ Basement w/plumbing ☐ Basement wo/plumbing


Water Supply: ☐ Individual ☐ Public ☒ Community

Comments:/Conditions:


1"=60'

Comments:/Conditions: 3/17/06 Checked tanks 86' 3/28/06 lines Checked

INITIAL SITE SKETCH

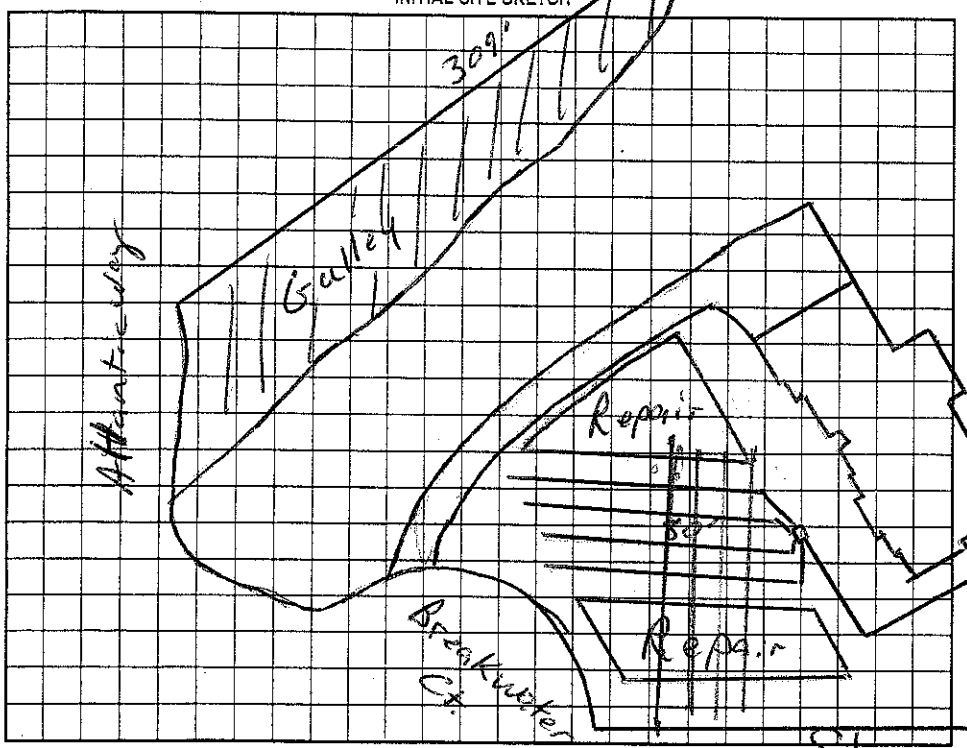

AS BUILT SKETCH

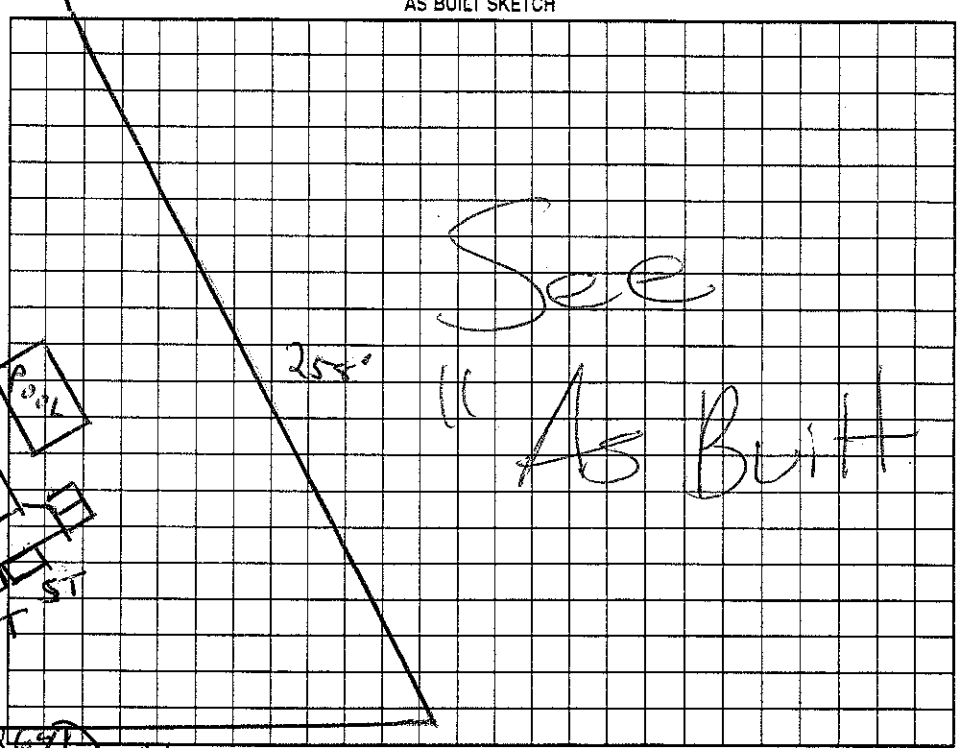

Permit can be suspended or revoked if any false information is supplied toward securing the permit/any unauthorized changes are made to the site/any unauthorized changes are made in the installation of the system. Improvement Permit with plat valid without expiration. Improvement Permit with site plan valid for sixty months. Authorization to Construct is valid for a period equal to that of Improvement Permit – not to exceed sixty months.

Signed: date 6-30-2005 Installed by: R&H

Improvement Permit by: RS date 6/28/05 Operation Permit by: date 5/16/06

Authorization to Construct by: RS date 6/28/05 Existing System Inspection by: date

HEALTH DEPT. COPY: WHITE OWNER COPY (FINAL): YELLOW OWNER COPY (INITIAL): PINK