IREDELL COUNTY HEALTH DEPARTMENT

STATESVILLE 704-878-5305 MOORESVILLE 704-664-5281

IMPROVEMENT PERMIT / AUTHORIZATION TO CONSTRUCT / OPERATION PERMIT / EXISTING SYSTEM INSPECTION

3750.00 Eq. 2 2100

PERMIT# 130696 PIN# 4626912262 DATE 9-1-05

OWNER OR CONTRACTOR Simonini Builders PHONE: Business 980 722-9629 Home

ADDRESS 817 E. Morehead St #100 Charlotte NC 28202

LOCATION Brawley School Rd TL Great Point TL Wild Harbor TL Atlantic Way on right past Breakwater Ct

SUBDIVISION The Point BLOCK / SECTION 3 LOT 323 LOT AREA 1.14 Acre SITE CLASS PS DESIGN FLOW 600gpd L.T.A.R. .025

Septic Tank: 1500 Gallons; STB 338 Date 5-20-06
Pump Tank: 1500 Gallons; PT 477 Date 8-14-06
Pump Make: Myers Model ME-50 Serial No.
Nitrification Field: No Fields 1 Square Feet 1200' Linear Feet 400'
No Lines 4@ 100' Trench Width 24"-36" Max Trench Bottom Depth 36" Gravel Depth N/A

☒ New System ☐ Repair System Type: I, II, III, IV, V, VI
System Description: Pump-4-Panel Block
Repair System Description: Same
Maintenance Agreement Required: ☒ Yes ☐ No

☒ House/Mod. Home No. Bedrooms 5
☐ Mobile Home No. Bathrooms 4
☐ Business No. Employees
☐ Other
☐ Slab ☐ Crawl Space ☒ Basement w/plumbing ☐ Basement wo/plumbing


Water Supply: ☐ Individual ☒ Public ☐ Community

Comments/Conditions: Keep Septic System at least 10' From PL & 15' from Future pool. Drainfield must be at least 25' from basement wall


Comments/Conditions: Checked lines 8/20/06 MO
ST ~ 94ft to House 9/22/06

Scale 1:50

INITIAL SITE SKETCH

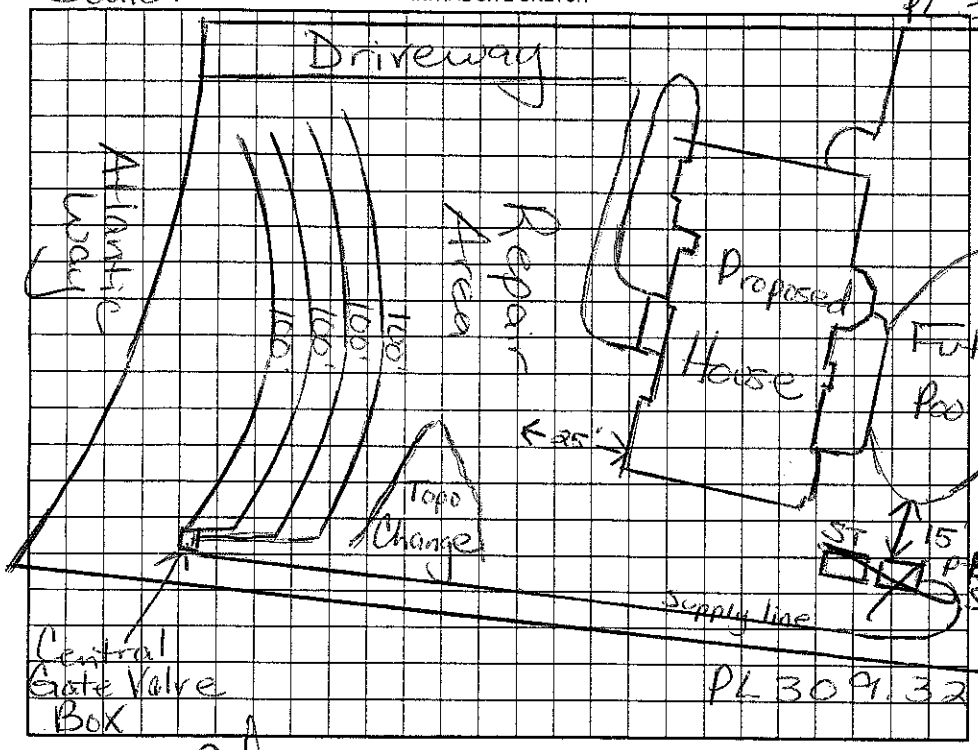

AS BUILT SKETCH

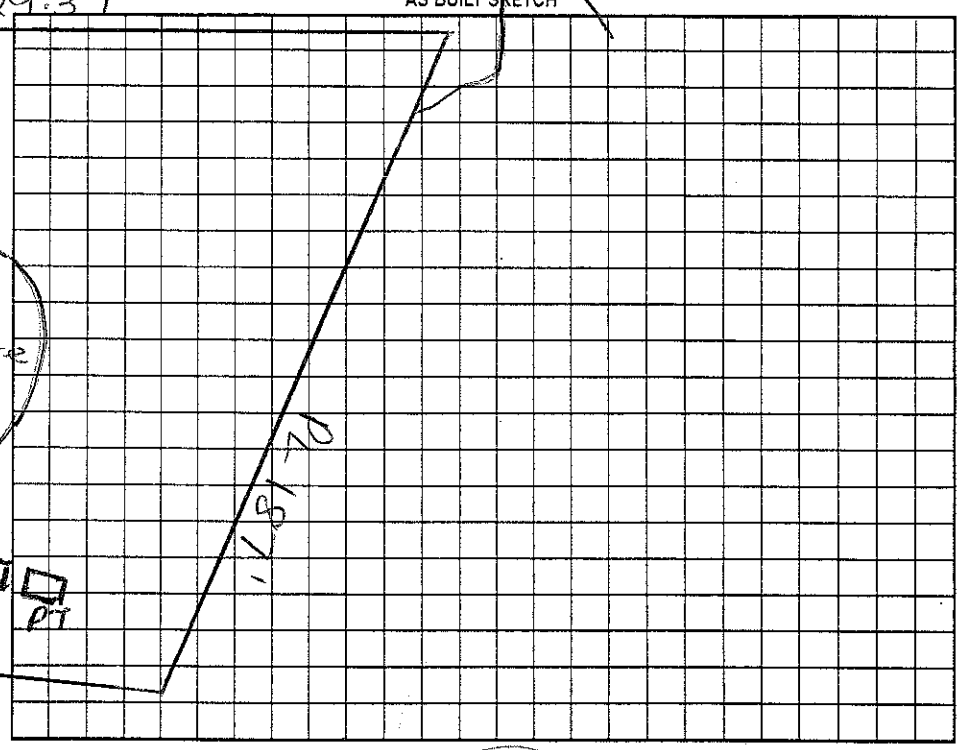

Permit can be suspended or revoked if any false information is supplied toward securing the permit/any unauthorized changes are made to the site/any unauthorized changes are made in the installation of the system. Improvement Permit with plat valid without expiration. Improvement Permit with site plan valid for sixty months. Authorization to Construct is valid for a period equal to that of Improvement Permit – not to exceed sixty months.

Signed: date 9.30.05 Installed by: R & H

Improvement Permit by: Maria H. Olson RS date 9/2/05 Operation Permit by: Maria H. Olson RS date 12/14/06

Authorization to Construct by: Maria H. Olson RS date 9/2/05 Existing System Inspection by: date

HEALTH DEPT. COPY: WHITE OWNER COPY (FINAL): YELLOW OWNER COPY (INITIAL): PINK