IREDELL COUNTY HEALTH DEPARTMENT

STATESVILLE 704-878-5305 — MOORESVILLE 704-664-5281

IMPROVEMENT PERMIT / AUTHORIZATION TO CONSTRUCT / OPERATION PERMIT / EXISTING SYSTEM INSPECTION

PERMIT# 130696 PIN# 4626 91 22 62 DATE 9-1-05

OWNER OR CONTRACTOR Simonini Builders PHONE: Business 980 722-9629 Home

ADDRESS 817 E. Morehead St #100 Charlotte NC 28202

LOCATION Brawley School Rd TL Great Point TL Wild Harbor TL Atlantic Way on right past Breakwater Ct

SUBDIVISION The Point BLOCK / SECTION 3 LOT 323 LOT AREA 1.14 Acre SITE CLASS. PS DESIGN FLOW 400 gpd L.T.A.R. .25

Septic Tank: 1500 Gallons; STB 338 Date 8-20-06

Pump Tank: 1500 Gallons; PT 477 Date 8-14-06

Pump Make: Myers Model ME-50 Serial No.

Nitrification Field: No. Fields 1 Square Feet 1200' Linear Feet 400'

No. Lines 4@100' Trench Width 24"-36" Max Trench Bottom Depth 36" Gravel Depth N/A"

☒ New System ☐ Repair System Type: I, II, III, IV, V, VI

System Description: Pump-LP-Panel Block

Repair System Description: Same

Maintenance Agreement Required: ☒ Yes ☐ No

☒ House/Mod. Home ☐ Mobile Home ☐ Business ☐ Other

No. Bedrooms 5/4 No. Bathrooms 4 No. Employees

☐ Slab ☐ Crawl Space ☒ Basement w/plumbing ☐ Basement wo/plumbing

Water Supply: ☐ Individual ☒ Public ☐ Community


Comments:/Conditions: Keep Septic System at least 10' From PL & 15' from Future pool. Drainfield must be at least 25' from basement wall.

Comments:/Conditions: Checked lines 8/20/06 ME


ST ~ 94ft to House 9/28/06

Scale 1:50

INITIAL SITE SKETCH

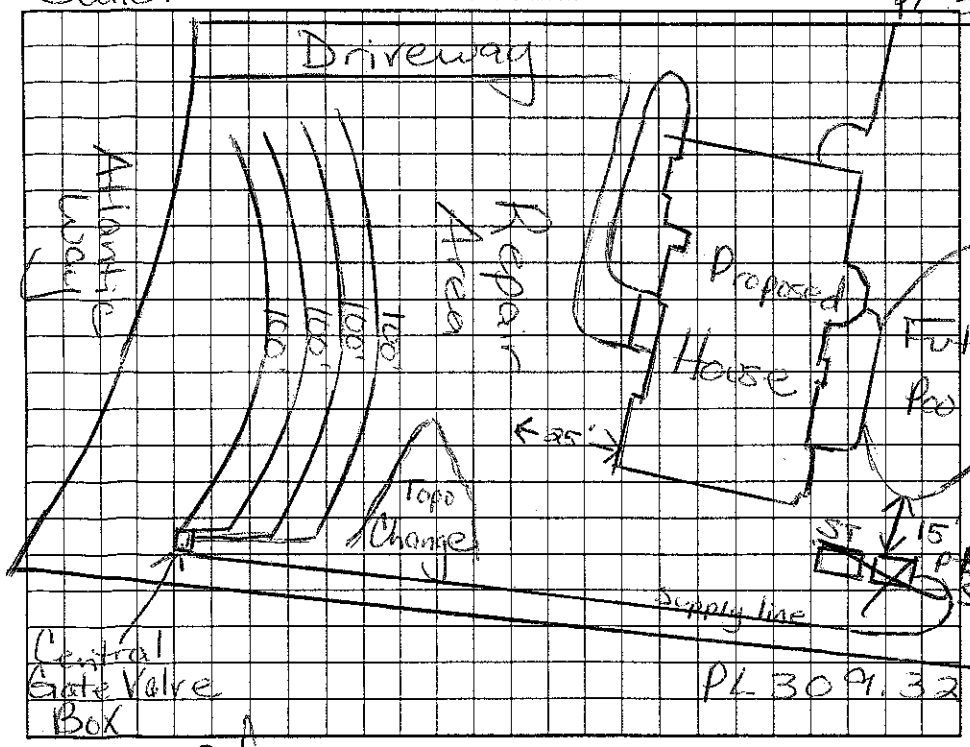

AS BUILT SKETCH

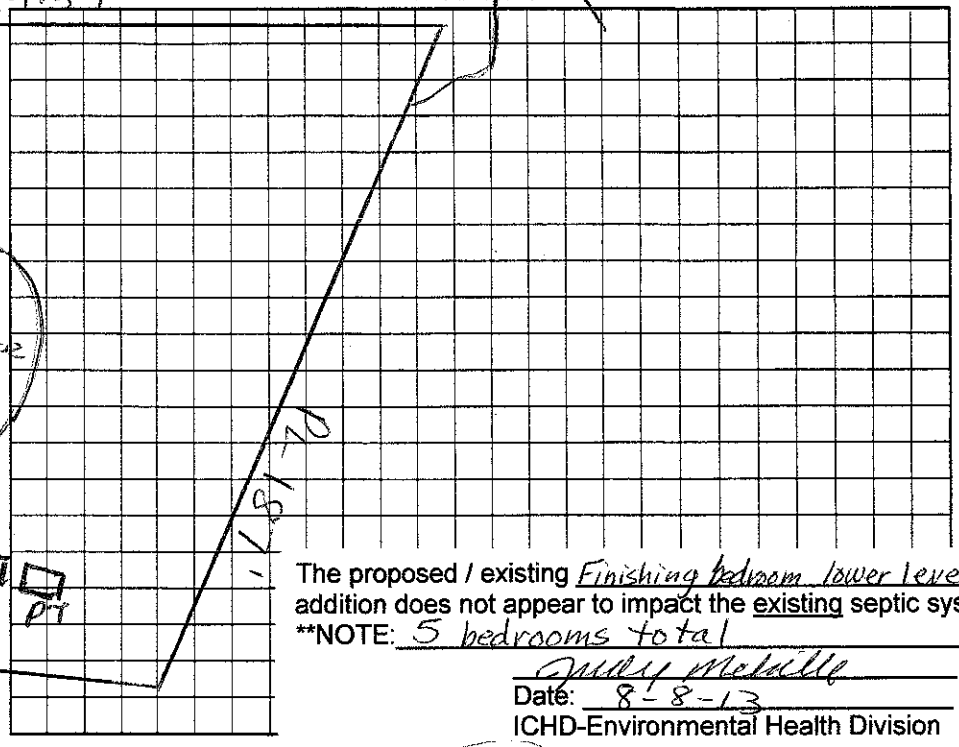

The proposed / existing Finishing bedroom lower level addition does not appear to impact the existing septic system.

**NOTE: 5 bedrooms total

Judy Melville R.S.

Date: 8-8-13

ICHD-Environmental Health Division

Permit can be suspended or revoked if any false information is supplied toward securing the permit/any unauthorized changes are made to the site/any unauthorized changes are made in the installation of the system. Improvement Permit with plat valid without expiration. Improvement Permit with site plan valid for sixty months. Authorization to Construct is valid for a period equal to that of Improvement Permit – not to exceed sixty months.

Signed: date 9.30.05 Installed by: R & H date

Improvement Permit by: Maria H. Dotson RS date 9/2/05 Operation Permit by: Maria H. Dotson RS date 12/14/06

Authorization to Construct by: Maria H. Dotson RS date 9/2/05 Existing System Inspection by: date

HEALTH DEPT. COPY: WHITE OWNER COPY (FINAL): YELLOW OWNER COPY (INITIAL): PINK