IREDELL COUNTY HEALTH DEPARTMENT

STATESVILLE 704-878-5305 #125 This file. L-30-2000 MOORESVILLE 704-664-5281

IMPROVEMENT PERMIT / AUTHORIZATION TO CONSTRUCT / OPERATION PERMIT / EXISTING SYSTEM INSPECTION

PERMIT# 078635 PIN# 4625941664 (pt.) Hughes & Assoc. 4621e-91-3568 DATE June 7, '99

OWNER OR CONTRACTOR Crescent Resources Inc. // The Point Operator // PHONE: Business 660-1185 Home

ADDRESS 2214 Brawley Sch Rd. Mooresville

LOCATION Brawley Sch Rd T Great Point Drive T Whitehaven Rd T Atlantic Way, on left across from Breakwater Ct.

SUBDIVISION The Point BLOCK / SECTION II LOT 335 LOT AREA 36,429 ft² SITE CLASS. PS DESIGN FLOW 440gpd L.T.A.R. .25-.3

Septic Tank: 1000+ Gallons; STB 338 Date 8/22/99

Pump Tank: Gallons; PT Date

Pump Make: Model Serial No.

Nitrification Field: No Fields 1 Square Feet 1320 Linear Feet 440

No Lines 4@110' Trench Width 36" Max Trench Bottom Depth 36" Gravel Depth N/A

☑ New System ☐ Repair System Type: I, II, III, IV, V, VI

System Description: GRAVITY INNOVATIVE -25% Red

Repair System Description: 12 Panel Block

Maintenance Agreement Required: ☐ Yes ☑ No

☐ House/Mod. Home ☐ Mobile Home ☐ Business ☐ Other

No. Bedrooms 4/4 No. Bathrooms No. Employees

☑ Slab ☑ Crawl Space ☐ Basement w/plumbing ☐ Basement wo/plumbing

Water Supply: ☐ Individual ☑ Public ☑ Community


Comments:/Conditions:

Comments:/Conditions:

*ONE inspection port per Lateral.

8-9-99 Need to modify Bonus Room to eliminate door of 4th "stacked" closet.

INITIAL SITE SKETCH

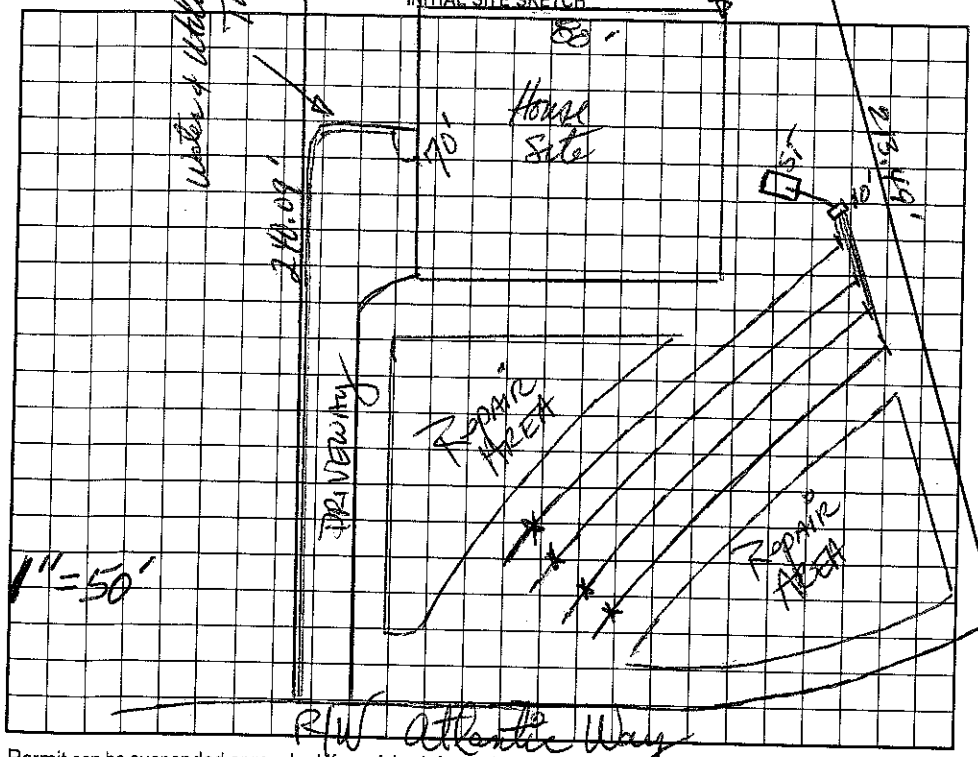

AS BUILT SKETCH

Permit can be suspended or revoked if any false information is supplied toward securing the permit/any unauthorized changes are made to the site/any unauthorized changes are made in the installation of the system. Improvement Permit with plat valid without expiration. Improvement Permit with site plan valid for sixty months. Authorization to Construct is valid for a period equal to that of Improvement Permit – not to exceed sixty months.

Signed: [signature] date 6-9-99

Improvement Permit by: [signature], RS date 6-7-99

Authorization to Construct by: [signature], RS date 8-9-99

Installed by: R+H Inc

Operation Permit by: Wesley Sparks RS date 12/2/99

Existing System Inspection by: date

HEALTH DEPT. COPY: WHITE OWNER COPY (FINAL): YELLOW OWNER COPY (INITIAL): PINK