IREDELL COUNTY HEALTH DEPARTMENT

$125

STATESVILLE 704-878-5305 MOORESVILLE 704-664-5281

IMPROVEMENT PERMIT / AUTHORIZATION TO CONSTRUCT / OPERATION PERMIT / EXISTING SYSTEM INSPECTION

PERMIT# 078636 PIN# 4625941684 (pt.) DATE June 7, '99

OWNER OR CONTRACTOR Crescent Resources, LLC / The Point on Wickham II / David Dibble Custom Homes PHONE: Business 660-1185 Home 4626-91-3742

ADDRESS 2214 Brawley Sch. Rd. Mooresville

LOCATION Brawley Sch. Rd. TL Coast Point Dr. TL Wild Harbor Rd TL Atlantic Way on left

SUBDIVISION The Point BLOCK/SECTION III LOT 336 LOT AREA 36,475 sf SITE CLASS. RS DESIGN FLOW 480 gpd L.T.A.R. no. 25

Septic Tank: 1000+ Gallons; STB 794 Date 9/26/99
Pump Tank: ____ Gallons; PT ____ Date ____
Pump Make: ____ Model ____ Serial No. ____
Nitrification Field: No Fields 1 Square Feet 1440 Linear Feet 480
No Lines 4@120' Trench Width 36" Max Trench Bottom Depth 36"

☑ New System ☐ Repair System Type: I, II, III, IV, V, VI
System Description: GRAVITY INNOVATIVE-25% Red.
Repair System Description: LP PANEL Back
Maintenance Agreement Required: ☐ Yes ☒ No
Gravel Depth N/A

☑ House/Mod. Home ☐ Mobile Home ☐ Business ☐ Other
No. Bedrooms 4 No. Bathrooms 4 No. Employees ____


☐ Slab ☑ Crawl Space ☐ Basement w/plumbing ☐ Basement wo/plumbing

Water Supply: ☐ Individual ☒ Public ☐ Community


Comments:/Conditions:
Recommend EEE 222 LAy - HDS 2012 due to contour.
8-26-99 Reviewed house site plan - appears in compliance w/ IP except driveway must be on/along left side pl. DRH

Comments:/Conditions: 1/3/00 - Checked 3 lines - Acc's

INITIAL SITE SKETCH

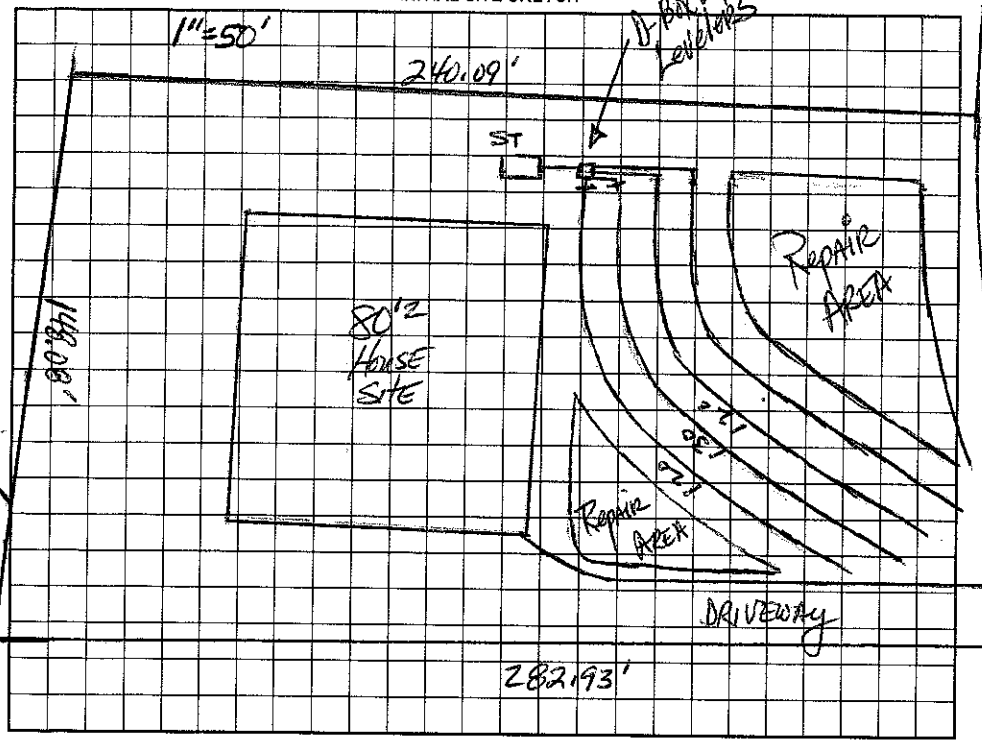

AS BUILT SKETCH

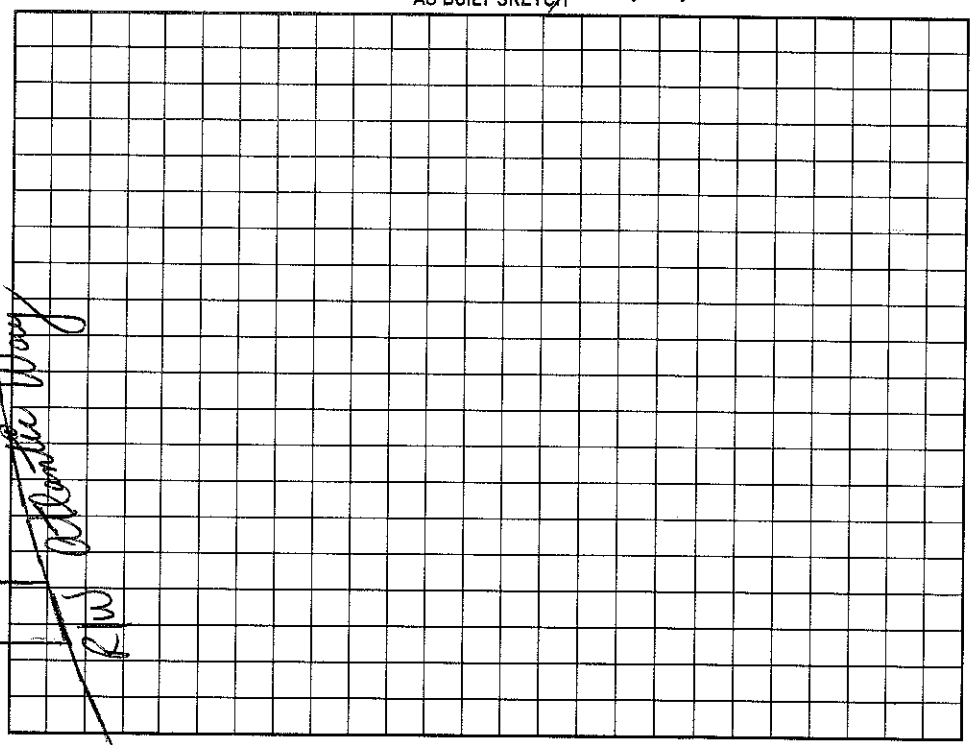

Permit can be suspended or revoked if any false information is supplied toward securing the permit/any unauthorized changes are made to the site/any unauthorized changes are made in the installation of the system. Improvement Permit with ~~plat valid~~ without ~~expiration~~. Improvement Permit with site plan valid for sixty months. Authorization to Construct is valid for a period equal to that of Improvement Permit – not to exceed sixty months.

Signed: Paul C. Penny date 6-9-99

Improvement Permit by: D R Simmons RS date 6-7-99

Authorization to Construct by: D R Simmons date 8-26-99

Installed by: Orbison Const. Co.

Operation Permit by: Wesley Sparks RS date 1/7/00

Existing System Inspection by: ____ date ____

HEALTH DEPT. COPY: WHITE OWNER COPY (FINAL): YELLOW OWNER COPY (INITIAL): PINK