115130

IREDELL COUNTY HEALTH DEPARTMENT

STATESVILLE 704-878-5305 MOORESVILLE 704-664-5281

IMPROVEMENT PERMIT / AUTHORIZATION TO CONSTRUCT / OPERATION PERMIT / EXISTING SYSTEM INSPECTION

PERMIT# 078637 PIN# 4625941684 4626-91-3806 DATE 5/24/04

OWNER OR CONTRACTOR Arcadia Homes PHONE: Business 662-6631 Home

ADDRESS P.O. Box 471941 Charlotte, NC 28247

LOCATION Brawley School Rd TL Great Point Drive TL Wild Harbor TL Atlantic Way on left

SUBDIVISION The Point BLOCK / SECTION III LOT 337 LOT AREA 49253 SITE CLASS PS DESIGN FLOW 480gpd L.T.A.R. ~.25

Septic Tank: 1000+ Gallons; STB Date

Pump Tank: Installed 1500 Gallons; PT Date

Pump Make: Model Serial No.

Nitrification Field: No Fields 1 Square Feet 1440 Linear Feet 480

No Lines 4@ 120' Trench Width 36" Max Trench Bottom Depth 36" Gravel Depth N/A

☒ New System ☐ Repair System Type: I, II, III, IV, V, VI

System Description: Gravity - 25% Reduction

Repair System Description Grav/Pump 25% Reduction to 50% Red

Maintenance Agreement Required: ☐ Yes ☐ No

☐ House/Mod. Home No. Bedrooms 4

☐ Mobile Home No. Bathrooms 3.5

☐ Business No. Employees

☐ Other

☐ Slab ☒ Crawl Space ☐ Basement w/plumbing ☐ Basement wo/plumbing


Water Supply: ☐ Individual ☒ Public ☒ Community

Comments:/Conditions:


Comments:/Conditions:

Scale 1:50

INITIAL SITE SKETCH PL 282.93

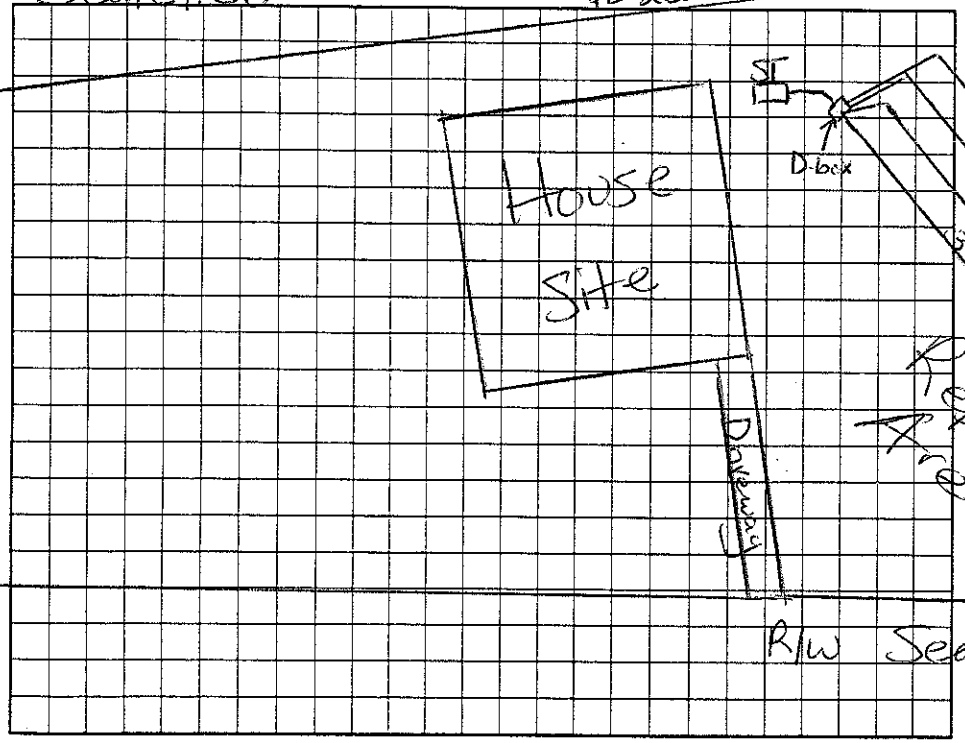

AS BUILT SKETCH

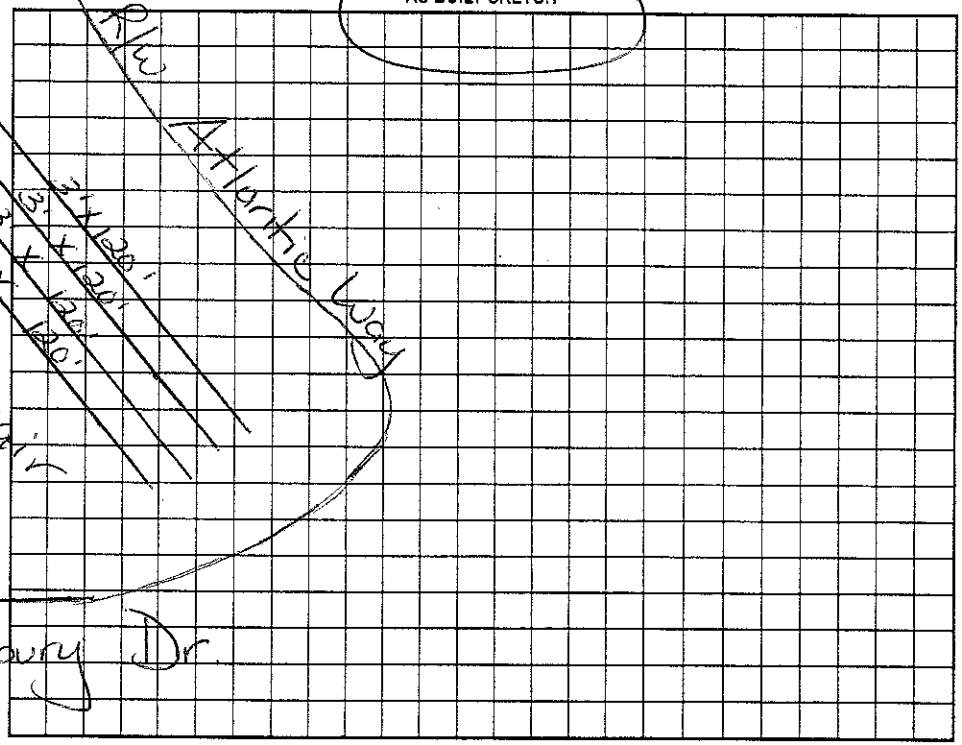

Permit can be suspended or revoked if any false information is supplied toward securing the permit/any unauthorized changes are made to the site/any unauthorized changes are made in the installation of the system. Improvement Permit with plat valid without expiration. Improvement Permit with site plan valid for sixty months. Authorization to Construct is valid for a period equal to that of Improvement Permit – not to exceed sixty months.

Signed: date 5-24-04 Installed by: R&H RS

Improvement Permit by: Maria H Dotson RS date 5/24/04 Operation Permit by: Maria H Dotson RS date 5/24/04

Authorization to Construct by: Maria H Dotson RS date 5/24/04 Existing System Inspection by: date

HEALTH DEPT. COPY: WHITE OWNER COPY (FINAL): YELLOW OWNER COPY (INITIAL): PINK