IREDELL COUNTY HEALTH DEPARTMENT

STATESVILLE 704-878-5305 MOORESVILLE 704-664-5281

IMPROVEMENT PERMIT / AUTHORIZATION TO CONSTRUCT / OPERATION PERMIT / EXISTING SYSTEM INSPECTION

PERMIT# 125482 PIN# 4625941684 4626-91-3806 DATE 4-28-05

OWNER OR CONTRACTOR Arcadia Homes PHONE: Business 662-6631 Home

ADDRESS P.O. Box 471941 Charlotte, NC 28247

LOCATION Brawley School Rd TL Great Point TL Wild Harbour TL Atlantic Way on left

SUBDIVISION The Point BLOCK / SECTION 3 LOT 337 LOT AREA SITE CLASS. PS DESIGN FLOW 480gpd L.T.A.R. N/A

Exist Septic Tank: 1500 Gallons; STB Date

Pump Tank: Gallons; PT Date

Pump Make: Model Serial No.

Exist Distribution Field: No Fields 1 Square Feet 1446 Linear Feet 480

No Lines 4@120' Trench Width 36" Max Trench Bottom Depth 36" Gravel Depth N/A

☐ New System ☐ Repair System Type: I, II, III, IV, V

System Description: Exist Gravity-25% Reduct.

Repair System Description Grav/Pump 50% Red.

Maintenance Agreement Required: ☐ Yes ☐ No

☒ House/Mod. Home No. Bedrooms 4

☐ Mobile Home No. Bathrooms

☐ Business No. Employees

☐ Other

☐ Slab ☒ Crawl Space ☐ Basement w/plumbing ☐ Basement wo/plumbing

Water Supply: ☐ Individual ☒ Public ☐ Community


Comments:/Conditions: Existing Septic System appears to be Functioning OK@ at time of inspection. Noted Inspection port covers on 1st & 4th lines need to be replaced.

Comments:/Conditions: Addition to House does not impact Septic System or Change Design Flow.


INITIAL SITE SKETCH

Scale 1"=50'

PL 282.43

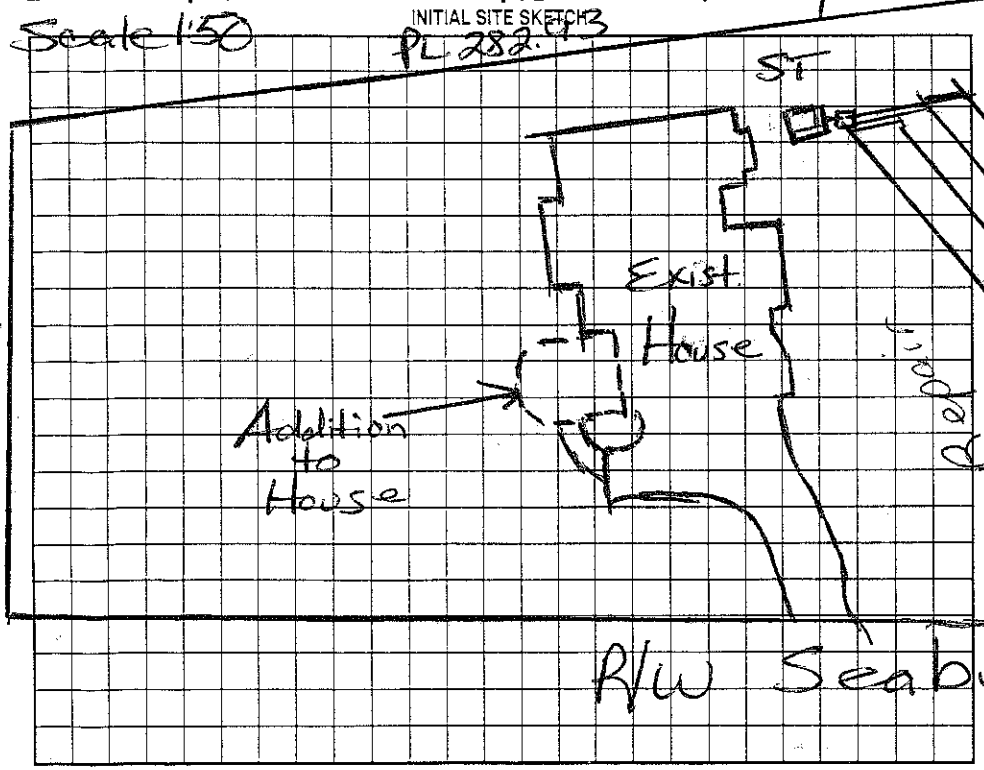

AS BUILT SKETCH

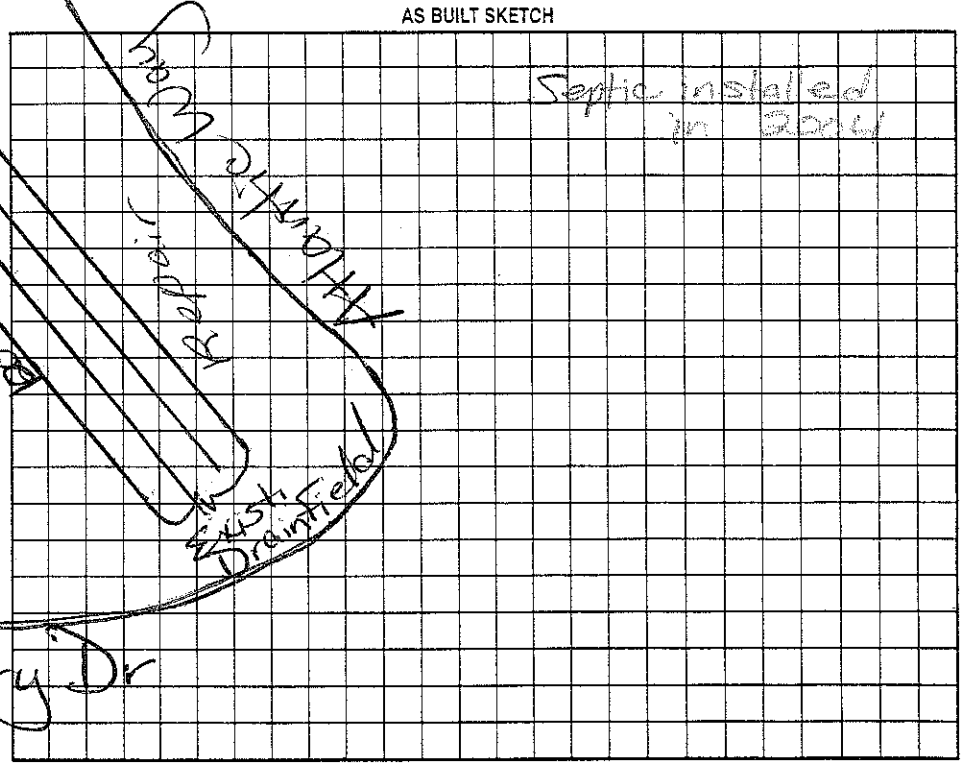

PL 128

Permit can be suspended or revoked if any false information is supplied toward securing the permit/any unauthorized changes are made to the site/any unauthorized changes are made in the installation of the system. Improvement Permit with plat valid without expiration. Improvement Permit with site plan valid for sixty months. Authorization to Construct is valid for a period equal to that of Improvement Permit – not to exceed sixty months.

Signed: X date 4-28-05 Installed by:

Improvement Permit by: date 4/28/05 Operation Permit by: date

Authorization to Construct by: date Existing System Inspection by: RS date 4/28/05

HEALTH DEPT. COPY: WHITE OWNER COPY (FINAL): YELLOW OWNER COPY (INITIAL): PINK