IREDELL COUNTY HEALTH DEPARTMENT

STATESVILLE 704-878-5305 $245 MOORESVILLE 704-664-5281

IMPROVEMENT PERMIT / AUTHORIZATION TO CONSTRUCT / OPERATION PERMIT / EXISTING SYSTEM INSPECTION

11/7222

PERMIT# 1777107 8634 PIN# ~~4625-94-T684~~ 4626-91-4474 DATE 6/8/04

OWNER OR CONTRACTOR Kingswood Homes PHONE: Business 704-506-3456 Home

ADDRESS 8033 Corporate Center Dr. Charlotte NC. 28226

LOCATION Lot 334 / 1100 TL Deer Point TL Wild Harbor TL Atlantic Way Left on (L)

SUBDIVISION Point BLOCK / SECTION 3 LOT 334 LOT AREA 36,887 Ft² SITE CLASS. PS DESIGN FLOW 600 L.T.A.R. .3

Septic Tank: 1500 Gallons: STB 338 Date 5/11/04
Pump Tank: 1500 Gallons: PT 421 Date 5/11/04
Pump Make: Goulds Model WE0-B12 ~~STB~~ No.
Nitrification Field: No Fields 1 Square Feet 666/999 Linear Feet 333
No Lines ~~6 @ 55'~~ Trench Width 2-3' Max Trench Bottom Depth 3' Gravel Depth NA

☒ New System ☐ Repair System Type: I, II, III, IV, V, VI
System Description: Pressure - 16" PPBPS
Repair System Description: 16" PPBPS
Maintenance Agreement Required: ☒ Yes ☐ No

☒ House/Mod. Home No. Bedrooms 5
☐ Mobile Home No. Bathrooms 4
☐ Business No. Employees
☐ Other
☐ Slab ☒ Crawl Space ☐ Basement w/plumbing ☐ Basement wo/plumbing


Water Supply: ☐ Individual ☐ Public ☒ Community
CL+F

Comments:/Conditions: 2' on 8' Centers, 3' on 9' centers
5 lines installed - for total 333 linear feet.


Comments:/Conditions:

(1" = 50')

INITIAL SITE SKETCH

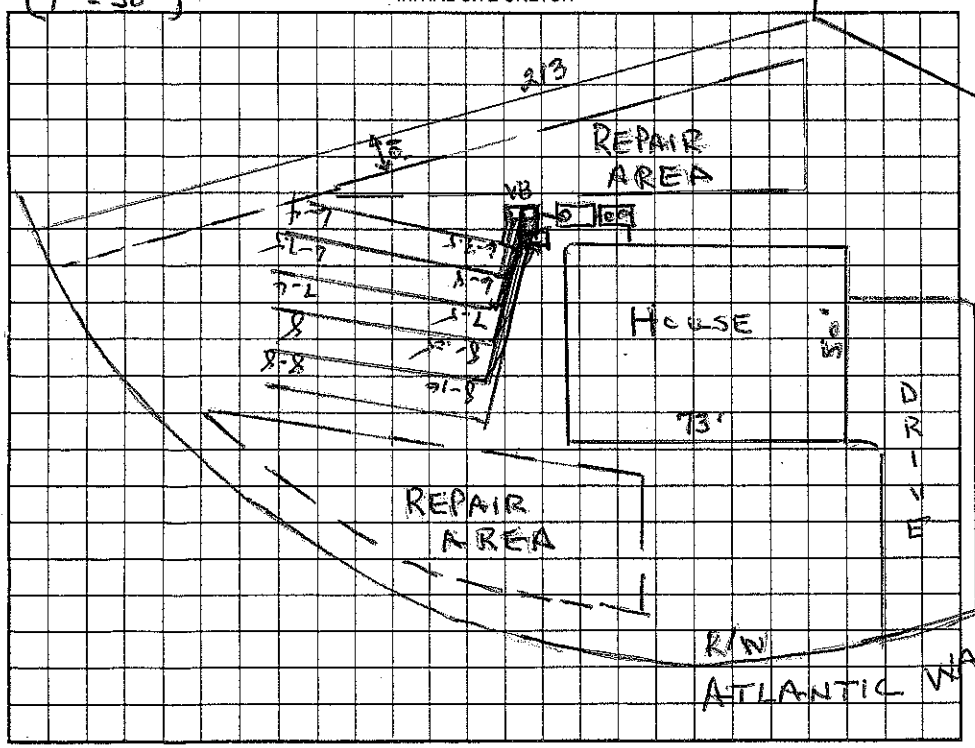

AS BUILT SKETCH

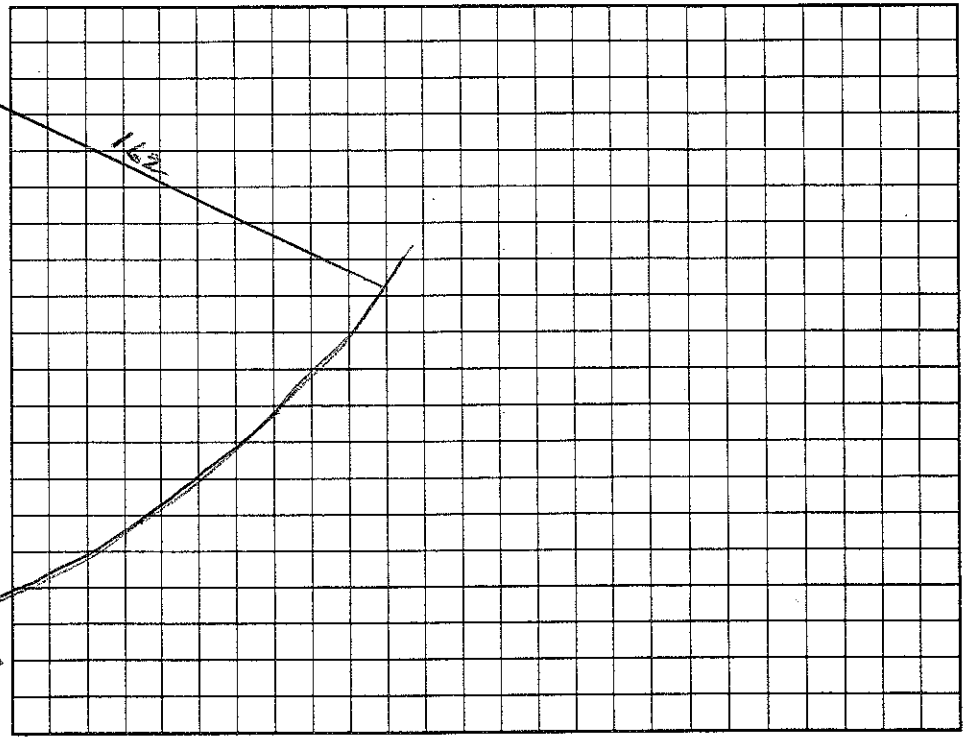

Permit can be suspended or revoked if any false information is supplied toward securing the permit/any unauthorized changes are made to the site/any unauthorized changes are made in the installation of the system. Improvement Permit with plat valid without expiration. Improvement Permit with site plan valid for sixty months. Authorization to Construct is valid for a period equal to that of Improvement Permit – not to exceed sixty months.

Signed: * [signature] date 6/8/04 Installed by: [signature illegible] O'Daniel

Improvement Permit by: Wesley Sparks R.S. date 6/8/04 Operation Permit by: Wesley Sparks R.S. date 6/24/04

Authorization to Construct by: Wesley Sparks R.S. date 6/8/04 Existing System Inspection by: date

HEALTH DEPT. COPY: WHITE OWNER COPY (FINAL): YELLOW OWNER COPY (INITIAL): PINK