IREDELL COUNTY HEALTH DEPARTMENT

STATESVILLE 704-878-5305 MOORESVILLE 704-664-5281

IMPROVEMENT PERMIT / AUTHORIZATION TO CONSTRUCT / OPERATION PERMIT / EXISTING SYSTEM INSPECTION

125

PERMIT# 078528 PIN# 4625941684 (pt.) Brookshire Const. 4626 91 5263 DATE May 10, '99

OWNER OR CONTRACTOR Crescent Resources/Duff The Point/Meeman PHONE: Business 660-1185 Home

ADDRESS 2214 Brawley Sch Rd. Mooresville

LOCATION Brawley Sch Rd TL Great Point Dr. TL Wild Harbor Rd. TL Atlantic Way (SFE 325A @ jct w/ Sealawy; 325 @ jct w/ Square Ct.)

SUBDIVISION The Point BLOCK \ SECTION III LOT 325 LOT AREA 35350 ft² + SFE 325A* SITE CLASS. * PS DESIGN FLOW 480 gpd L.T.A.R. ~.25

Septic Tank: 1500+ Gallons; STB 339 Date 4/13/02

Pump Tank: 1000 Gallons; PT 283 Date 3/12/02

Pump Make: MYERS Model ME150S-21 Serial No.

Nitrification Field: No Fields 1 Square Feet 1440 Linear Feet 480

No Lines 4 Trench Width 36" Max Trench Bottom Depth 36"

☑ New System ☐ Repair System Type: I, II, III, IV, V, VI

System Description: pm - Infiltrator on SFE 325A

Repair System Description: 2P Panel Block

Maintenance Agreement Required: ☐ Yes ☑ No initially

Gravel Depth NA

☐ Slab ☐ Crawl Space ☑ Basement w/plumbing ☐ Basement wo/plumbing

☑ House/Mod. Home ☐ Mobile Home ☐ Business ☐ Other

No. Bedrooms 4 No. Bathrooms 4 No. Employees


Water Supply: ☐ Individual ☑ Public ☐ Community

Comments/Conditions: HDS model 2012 a good option for Bending contour.


Comments/Conditions: EZ FLOW INSTALLED.

1" = 100'

INITIAL SITE SKETCH

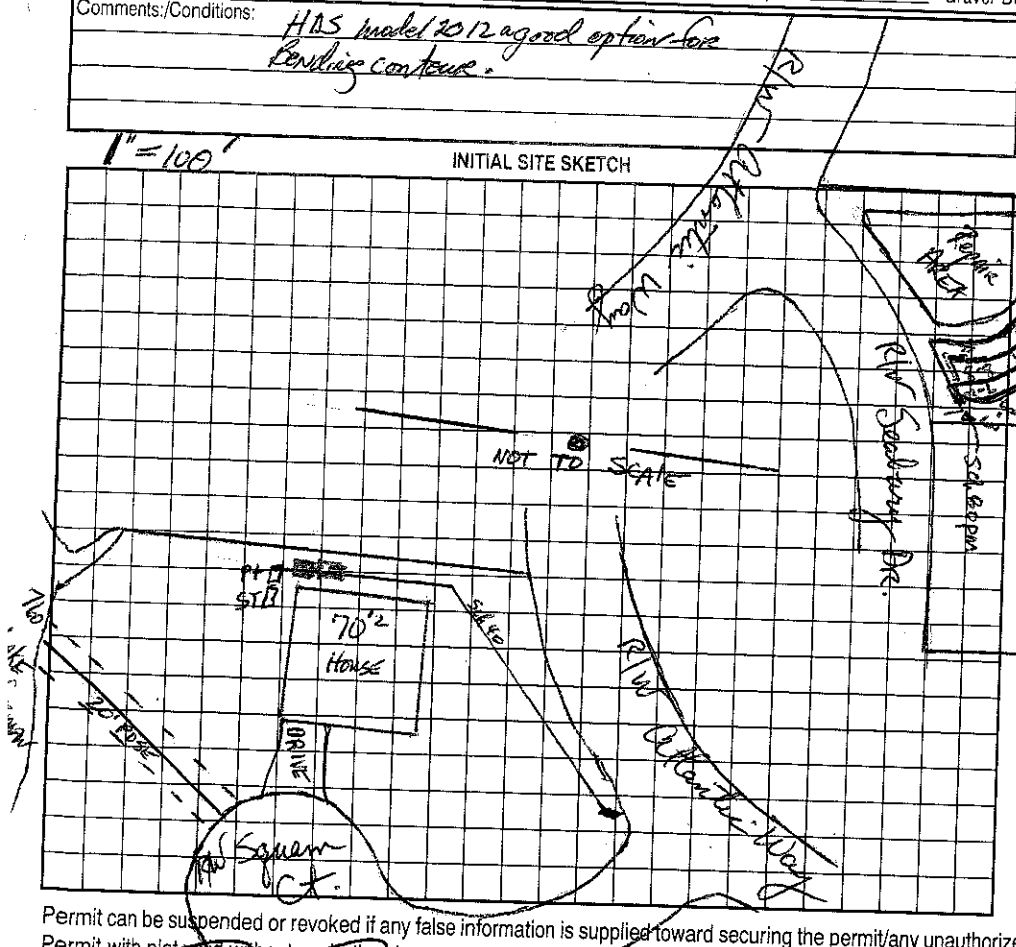

AS BUILT SKETCH

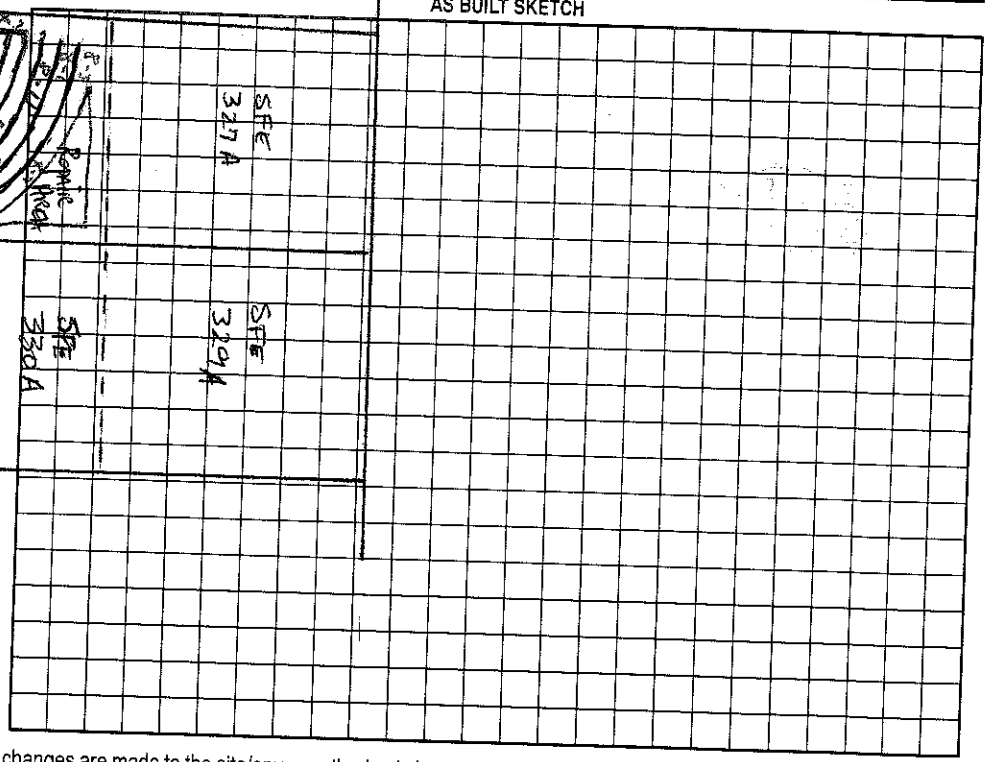

Permit can be suspended or revoked if any false information is supplied toward securing the permit/any unauthorized changes are made to the site/any unauthorized changes are made in the installation of the system. Improvement Permit with plat valid without expiration. Improvement Permit with site plan valid for sixty months. Authorization to Construct is valid for a period equal to that of Improvement Permit – not to exceed sixty months.

Signed: date 5-14-99 Installed by: Hallman Const. Inc.

Improvement Permit by: date 5-10-99

Authorization to Construct by: date 8-3-01 Operation Permit by: RS date 7/4/02

Existing System Inspection by: date

HEALTH DEPT. COPY: WHITE OWNER COPY (FINAL): YELLOW OWNER COPY (INITIAL): PINK