125

IREDELL COUNTY HEALTH DEPARTMENT

STATESVILLE 704-878-5305 MOORESVILLE 704-664-5281

IMPROVEMENT PERMIT / AUTHORIZATION TO CONSTRUCT / OPERATION PERMIT / EXISTING SYSTEM INSPECTION

PERMIT# 07B63 PIN# 4675-44-6684 (Lot) Brookshire Const. 4626915890 DATE May 11, 99

OWNER OR CONTRACTOR Crescent Resources dba The Point on Lake Norman PHONE: Business 660-1165 Home

ADDRESS 2214 Brawley Sch Rd + Mooresville

LOCATION Brawley Sch Rd TL Great Point Drive TL Middleharbor Rd. TR Atlantic Way - lot at end - SFE near jct w/ Seabury SFE

SUBDIVISION The Point BLOCK / SECTION III LOT 332, 332A LOT AREA 46034 RPA + SFE 332A SITE CLASS. PS SFE DESIGN FLOW 460gpd L.T.A.R. .5

Septic Tank: 1000+ Gallons; STB 336 Date 3-26-01

Pump Tank: 1000 Gallons; PT 27 Date 4-1-01

Pump Make: Model Serial No.

Nitrification Field: No Fields 1 Square Feet 1200 Linear Feet 400

No Lines 4 Trench Width 36" Max Trench Bottom Depth 36" Gravel Depth NA

☑ New System ☐ Repair System Type: I, II, III, IV, V, VI

System Description: PM - INNOVATIVE - 25% Reduction

Repair System Description: LP/PM INNOVATIVE - 25% Reduction

Maintenance Agreement Required: ☐ Yes ☑ No

☑ House/Mod. Home ☐ Mobile Home ☐ Business ☐ Other

No. Bedrooms 4 No. Bathrooms 4 No. Employees


☐ Slab ☐ Crawl Space ☑ Basement w/plumbing ☐ Basement wo/plumbing

Water Supply: ☐ Individual ☑ Public ☐ Community

Comments:/Conditions:

1"=100'


INITIAL SITE SKETCH

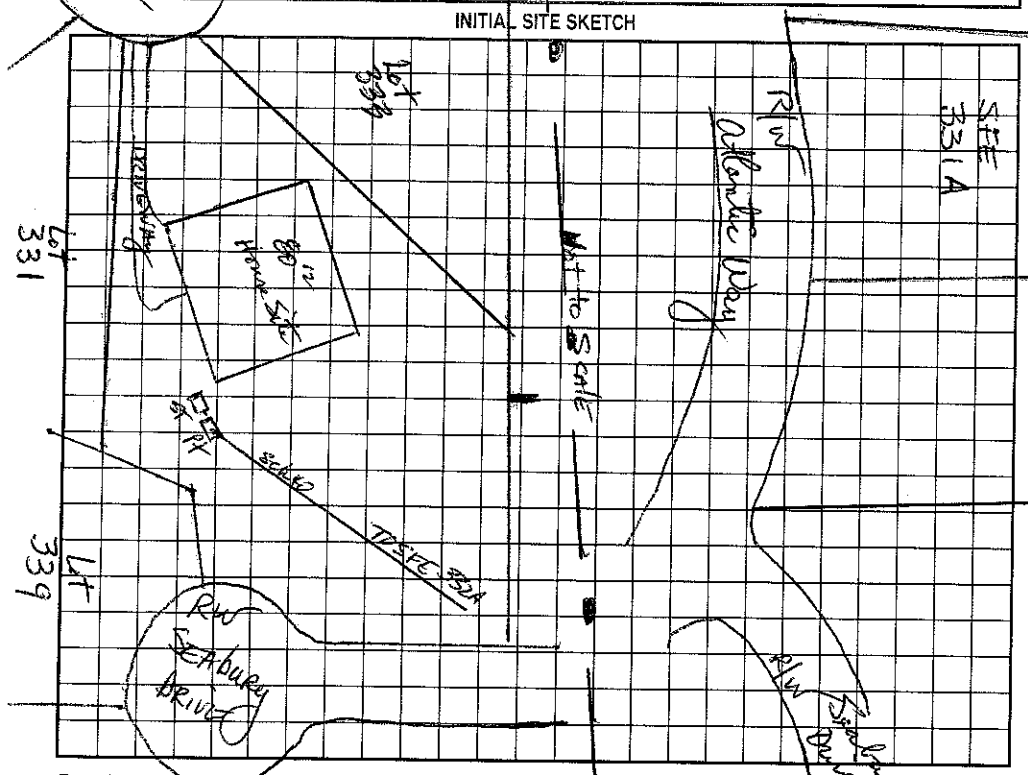

Comments:/Conditions:

Per David, "plans okay"

AS BUILT SKETCH

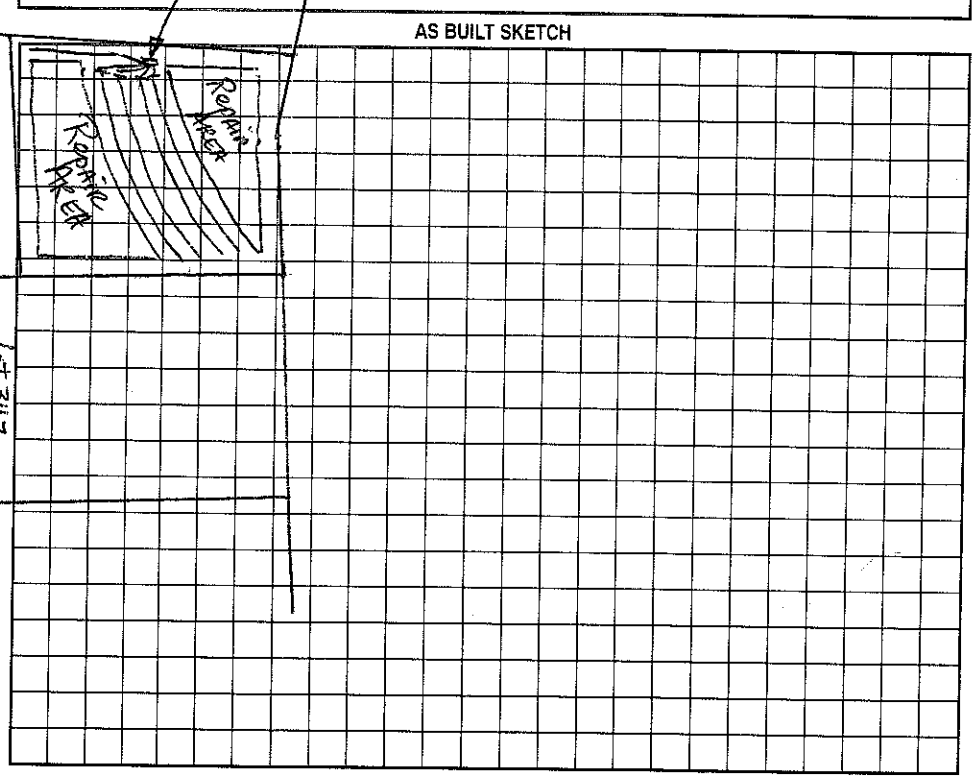

Permit can be suspended or revoked if any false information is supplied toward securing the permit/any unauthorized changes are made to the site/any unauthorized changes are made in the installation of the system. Improvement Permit with plat valid without expiration. Improvement Permit with site plan valid for sixty months. Authorization to Construct is valid for a period equal to that of Improvement Permit – not to exceed sixty months.

Signed: date 5-14-99 Installed by: R&H

Improvement Permit by: date 5-11-99 Operation Permit by: date 7/17/2001

Authorization to Construct by: date 9/25/00 Existing System Inspection by: date

HEALTH DEPT. COPY: WHITE OWNER COPY (FINAL): YELLOW OWNER COPY (INITIAL): PINK