IREDELL COUNTY HEALTH DEPARTMENT

STATESVILLE 704-878-5305 MOORESVILLE 704-664-5281

IMPROVEMENT PERMIT / AUTHORIZATION TO CONSTRUCT / OPERATION PERMIT / EXISTING SYSTEM INSPECTION

$550

PERMIT# 132032 PIN# 4626917980 DATE 11-15-05

OWNER OR APPLICANT David Dibble Custom Homes PHONE: Business 799-1688 Chris Home

ADDRESS P.O. Box 4717 Mooresville, NC 28117

LOCATION Brawley School Rd TR Great Point Dr TL Wild Harbour Rd TL Atlantic Way TL Seabury

SUBDIVISION The Point BLOCK / SECTION 3 LOT 339 LOT AREA .944 SITE CLASS PS DESIGN FLOW 480gpd L.T.A.R. e3

Septic Tank: 1000+ Gallons; STB 444 Date 9/13/06
Pump Tank: 1000 Gallons; PT 283 Date 9/18/06
Pump Make: Gould Model WE07121H Serial No.
Nitrification Field: No Fields 1 Square Feet 600 Linear Feet 300'
No Lines 3@100' Trench Width * See note Max Trench Bottom Depth 36" Gravel Depth N/A

☒ New System ☐ Repair ☐ Expansion System Type: I II III IV V VI
System Description: Pump-Lp-Panel Block
Repair System Description: Same
Maintenance Agreement Required: ☒ Yes ☐ No

☒ House/Mod. Home ☐ Mobile Home ☐ Business ☐ Other
No. Bedrooms 4 No. Persons No. Employees


Water Supply: ☐ Individual ☒ Public ☒ Community

☐ Gravity ☐ Pressure ☐ Slab ☐ Crawl Space ☒ Basement w/plumbing ☐ Basement wo/plumbing

Comments/Conditions: * Note: Follow trench width specified in "Installation Specifications On-Site Wastewater Disposal" for Crescent Communities

Comments/Conditions: * Keep Drainfield at least 25' (upslope) of basement wall.

INITIAL SITE SKETCH Scale 1:50

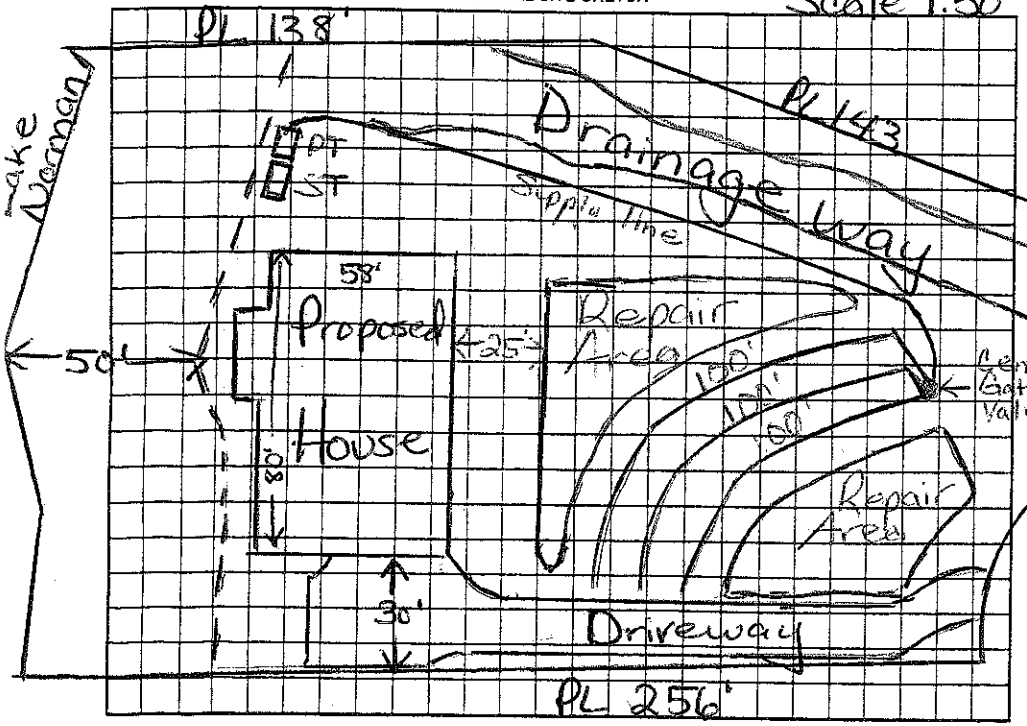

AS BUILT SKETCH

Permit can be suspended or revoked if any false information is supplied toward securing the permit/any unauthorized changes are made to the site/any unauthorized changes are made in the installation of the system. Improvement Permit with plat valid without expiration ☐ Improvement Permit with site plan valid for sixty months ☐ Authorization to Construct is valid for a period equal to that of Improvement Permit – not to exceed sixty months.

Signed: [signature] date 11/11/05 Installed by: Orbison

Improvement Permit by: Maria H. Dotson RS date 11/15/05 Operation Permit by: [signature] RS date 9/12/06

Authorization to Construct by: Maria H. Dotson RS date 11/15/05 Existing System Inspection by: date

HEALTH DEPT. COPY: WHITE OWNER COPY (FINAL): YELLOW OWNER COPY (INITIAL): PINK