IREDELL COUNTY HEALTH DEPARTMENT

STATESVILLE 704-878-5305 50.00 Paid MOORESVILLE 704-664-5281 2.00

IMPROVEMENT PERMIT / AUTHORIZATION TO CONSTRUCT / OPERATION PERMIT / EXISTING SYSTEM INSPECTION

PERMIT# 0786226 PIN# 4625941684 Pt. 4626 91 8331 DATE 11/9/2000

OWNER OR CONTRACTOR Crescent Resources/Arcadia Homes PHONE: Business 201-7181 Mobile Home

ADDRESS P.O. Box 471441 Charlotte, NC 28247

LOCATION Brawley School Rd TL Great Point Dr. TL Wild Harbor TL Atlantic Way TR Squam Ct

SUBDIVISION The Point BLOCK / SECTION III LOT 328 LOT AREA 31,828 ft² SITE CLASS. DESIGN FLOW L.T.A.R. .3

Septic Tank: 1500 Gallons; STB 338 Date 6/5/01
Pump Tank: 1500 Gallons; PT 338 Date 5/28/01
Pump Make: Model Serial No.
Nitrification Field: No Fields 1 Square Feet 1530 Linear Feet 510'
No Lines 4 Trench Width 36" Max Trench Bottom Depth 36" Gravel Depth N/A

☒ New System ☐ Repair System Type: I, II, (III), IV, V, VI
System Description: Pump (pm) 25% Reduction
Repair System Description: Pump Upp - Panel Block
Maintenance Agreement Required: ☐ Yes ☒ No


☒ House/Mod. Home No. Bedrooms 5
☐ Mobile Home No. Bathrooms 4.5
☐ Business No. Employees
☐ Other
☐ Slab ☒ Crawl Space ☐ Basement w/plumbing ☐ Basement wo/plumbing

Water Supply: ☐ Individual ☒ Public ☒ Community

Comments:/Conditions:
Scale = 1:50
* Install inspection port on each lateral.

Comments:/Conditions: E-Z Flow drainlines installed.
Filter & risers installed.

INITIAL SITE SKETCH

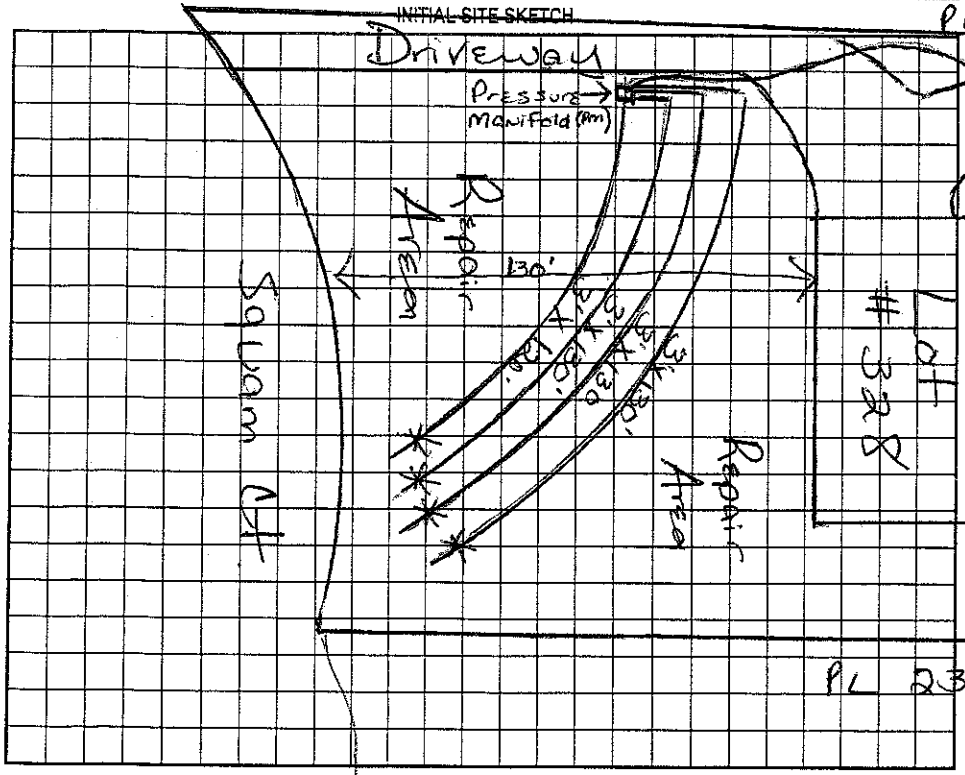

AS BUILT SKETCH

Permit can be suspended or revoked if any false information is supplied toward securing the permit/any unauthorized changes are made to the site/any unauthorized changes are made in the installation of the system. Improvement Permit with plat valid without expiration. Improvement Permit with site plan valid for sixty months. Authorization to Construct is valid for a period equal to that of Improvement Permit – not to exceed sixty months.

Signed: Vicky C. Seitz date 11-17-00 Installed by: R & H

Improvement Permit by: Maria H. Dotson RS date 11/9/2000 Operation Permit by: Maria H. Dotson RS date 2/19/2002

Authorization to Construct by: Maria H. Dotson RS date 11/9/2000 Existing System Inspection by: date

HEALTH DEPT. COPY: WHITE OWNER COPY (FINAL): YELLOW OWNER COPY (INITIAL): PINK