325

IREDELL COUNTY HEALTH DEPARTMENT

STATESVILLE 704-878-5305 MOORESVILLE 704-664-5281

IMPROVEMENT PERMIT / AUTHORIZATION TO CONSTRUCT / OPERATION PERMIT / EXISTING SYSTEM INSPECTION

PERMIT# 078629 PIN# 4625944684 (pt) 4626-91-8416 DATE May 10, '99

OWNER OR CONTRACTOR Crescent Resources dba/ The Point for Hoerner PHONE: Business 660-1185 Home

ADDRESS 2214 Brawley Sch Rd. Mooresville

LOCATION Brawley Sch Rd. TL Great Point DRIVE TL Wild Harbor RD TL Atlantic Way on Right past Spinnaker Ct.

SUBDIVISION The Point BLOCK / SECTION 11 LOT 329 LOT AREA 33,543 ft² SITE CLASS. PS DESIGN FLOW 460gpd L.T.A.R. no. 25

Septic Tank: 1000+ Gallons; STB 338 Date 5/13/60
Pump Tank: 1000 Gallons; PT 283 Date 3/24/60
Pump Make: MYERS Model ME-50S-2 Serial No. 5100
Nitrification Field: No Fields 1 Square Feet 1080 Linear Feet 360
No Lines 4@90' Trench Width 36" Max Trench Bottom Depth 36"

☑ New System ☐ Repair System Type: I, II, III, ⓥ V, VI
System Description: LP Panel Block
Repair System Description: LP Panel Block on 329A
Maintenance Agreement Required: ☑ Yes ☐ No

Gravel Depth N/A

☑ House/Mod. Home ☐ Mobile Home ☐ Business ☐ Other
No. Bedrooms 4 No. Bathrooms 4 No. Employees

☑ Slab ☑ Crawl Space ☑ Basement w/plumbing ☐ Basement wo/plumbing


Water Supply: ☐ Individual ☐ ~~Public~~ ☐ ~~Community~~

Comments:/Conditions:
9-16-99 Reviewed house plan - appears in compliance w/ LP
Builder to locate house as shown. DRH


Comments:/Conditions: (partial)

1"=50'

INITIAL SITE SKETCH

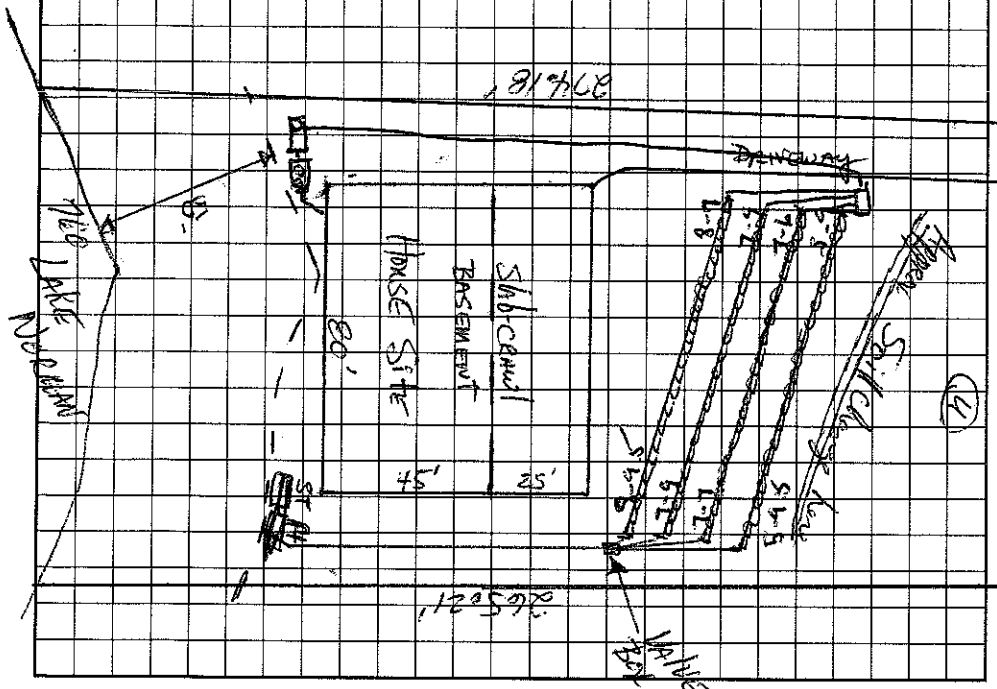

AS BUILT SKETCH

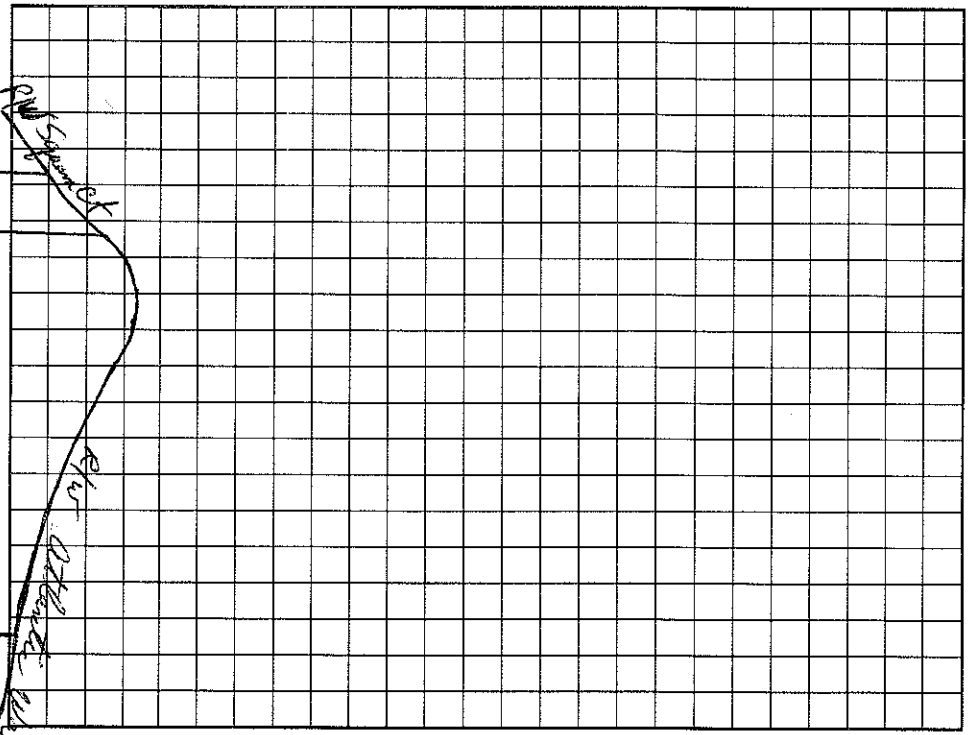

Permit can be suspended or revoked if any false information is supplied toward securing the permit/any unauthorized changes are made to the site/any unauthorized changes are made in the installation of the system. Improvement Permit with plat valid without expiration. Improvement Permit with site plan valid for sixty months. Authorization to Construct is valid for a period equal to that of Improvement Permit – not to exceed sixty months.

Signed: P.C. Pope date 5-14-99 Installed by: Orbison Const.

Improvement Permit by: [signature] date 5-11-99 Operation Permit by: Wesley Sparks R.S. date 11/7/00

Authorization to Construct by: [signature] date 9-16-99 Existing System Inspection by: date

HEALTH DEPT. COPY: WHITE OWNER COPY (FINAL): YELLOW OWNER COPY (INITIAL): PINK