IREDELL COUNTY HEALTH DEPARTMENT

STATESVILLE 704-878-5305 130.00 Paid MOORESVILLE 704-664-5281

IMPROVEMENT PERMIT / AUTHORIZATION TO CONSTRUCT / OPERATION PERMIT / EXISTING SYSTEM INSPECT.

PERMIT# 12991 5 PIN# 4626 91 8704 4626-91-8704 DATE 8-4-05

OWNER OR CONTRACTOR Alexander Chasnis / Lande PHONE: Business 339-1000 Home 567-5194

ADDRESS 1343 Anthem Ct Charlotte, NC 28205

LOCATION Brawley School Rd TL Great Point Dr. TL Wild Harbour TL Atlantic Way lot at end (Easement on left B4

SUBDIVISION The Point BLOCK / SECTION III LOT 331/331A LOT AREA 41,529 Ft2± SITE CLASS PS DESIGN FLOW 480gpd L.T.A.R. .25

Septic Tank: 1000+ Gallons; STB 444 Date 11-20-07
Pump Tank: 1000 Gallons; PT 27 Date 1-18-07
Pump Make: Myers Model P102 Serial No.
Nitrification Field: No. Fields 1 Square Feet 1440 Linear Feet 480'
No. Lines 4@120' Trench Width 36" Max Trench Bottom Depth 36" Gravel Depth N/A

☒ New System ☐ Repair System Type: I, II, III, IV, V, VI
System Description: Pump-PM-25% Reduction
Repair System Description: LP-25-50% Reduction
Maintenance Agreement Required: ☐ Yes ☒ No Not Initially ☐ Other

☒ House/Mod. Home ☐ Mobile Home ☐ Business No. Bedrooms 4/4 No. Bathrooms 4 No. Employees
☐ Slab ☐ Crawl Space ☒ Basement w/plumbing ☐ Basement wo/plumbing


Water Supply: ☐ Individual ☒ Public ☒ Community

Comments:/Conditions: Note: Drainfield (Initial & repair) located on Offsite Easement 331A.


Comments:/Conditions: Reviewed Building plans, in Compliance with original plans Tanks & lines Checked 11/8/08 Lot 331A Off site Easement 5/15/08 Set 2ft pressure

Scale 1:100'

INITIAL SITE SKETCH

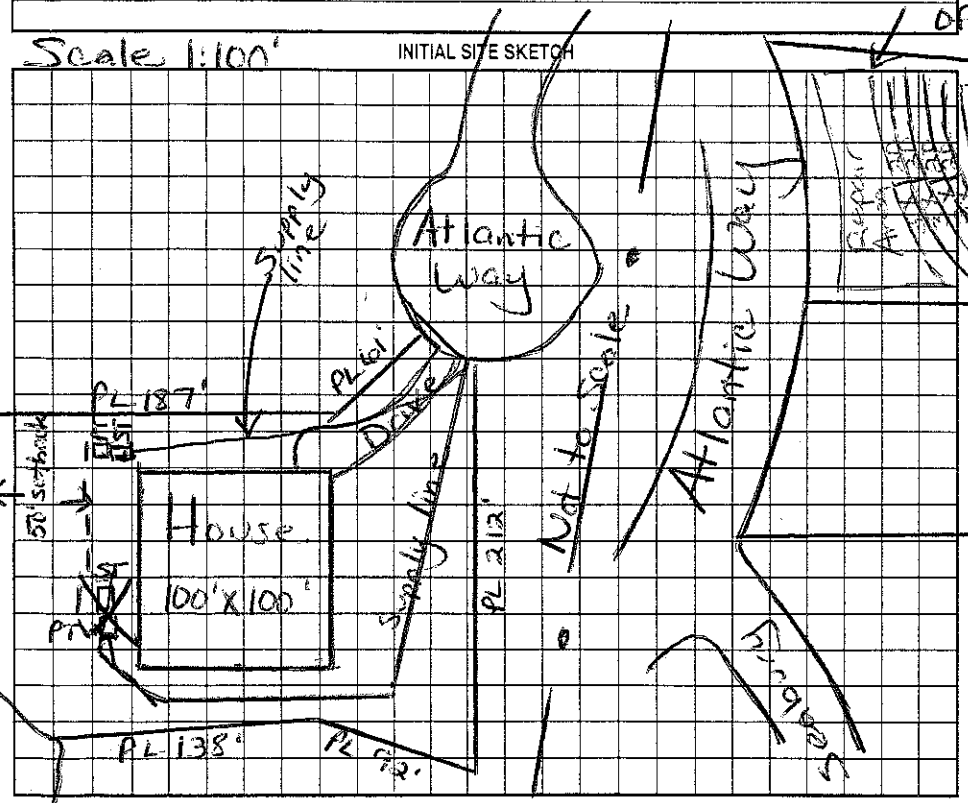

AS BUILT SKETCH

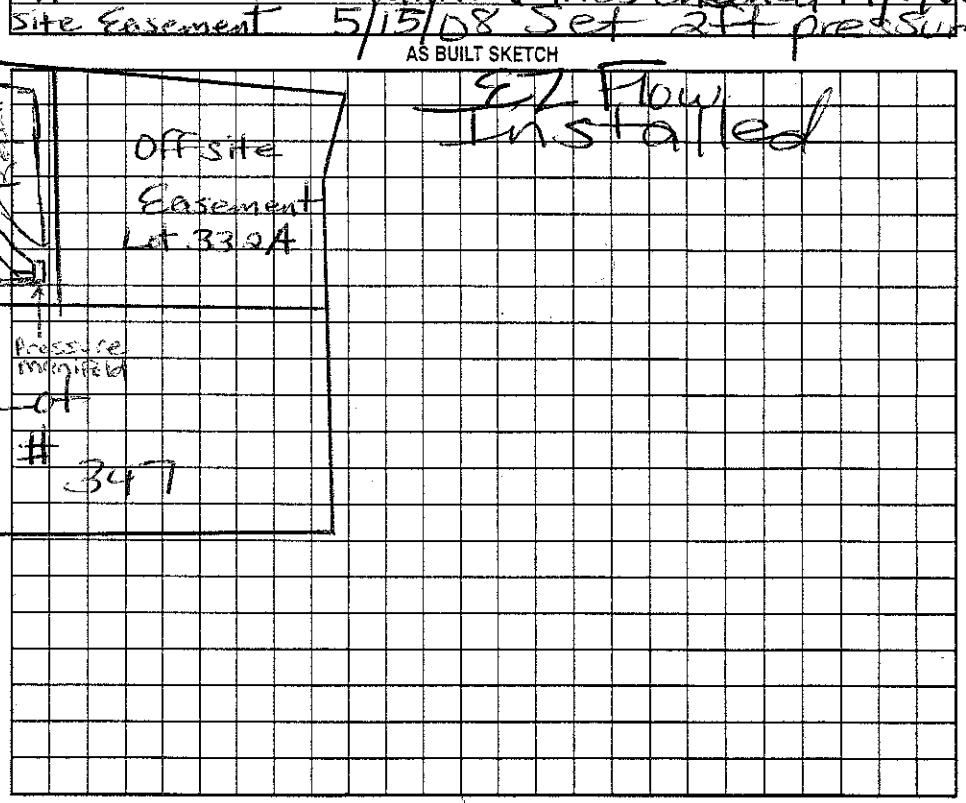

EZ Flow Installed

Permit can be suspended or revoked if any false information is supplied toward securing the permit/any unauthorized changes are made to the site/any unauthorized changes are made in the installation of the system. Improvement Permit with plat valid without expiration. Improvement Permit with site plan valid for sixty months. Authorization to Construct is valid for a period equal to that of Improvement Permit – not to exceed sixty months.

Signed: date 8/8/05 Installed by: R&M Dobson RS

Improvement Permit by: Maria H. Dobson RS date 8/4/05 Operation Permit by: Maria H. Dobson date 5/15/05

Authorization to Construct by: Maria H. Dobson RS date 4/16/07 Existing System Inspection by: date

HEALTH DEPT. COPY: WHITE OWNER COPY (FINAL): YELLOW OWNER COPY (INITIAL): PINK