117829

IREDELL COUNTY HEALTH DEPARTMENT

$125

STATESVILLE 704-878-5305 MOORESVILLE 704-664-5281

IMPROVEMENT PERMIT / AUTHORIZATION TO CONSTRUCT / OPERATION PERMIT / EXISTING SYSTEM INSPECTION

PERMIT# 078643 PIN# 4625946484 (PT.) 4626923180 DATE June 7, '99

OWNER OR CONTRACTOR Crescent Resources/The Point on Norman/ SIMONINI PHONE: Business 660-1185 Home

ADDRESS 2214 Brawley Sch Rd. Mooresville

LOCATION Brawley Sch Rd TL Goat Point Drive TR Wild Harbor Rd. TL Atlantic Way TR Seabury Drive on L

SUBDIVISION The Point BLOCK / SECTION III LOT 344 LOT AREA 43,508 ft² SITE CLASS. PS DESIGN FLOW 460 gpd L.T.A.R. .30

Septic Tank: 1600+ Gallons; STB 338 Date 7-9-04
Pump Tank: 1000 Gallons; PT 27 Date 6-21-04
Pump Make: Model Serial No.
Nitrification Field: No Fields 1 Square Feet 1200 Linear Feet 400
No Lines 4@100' Trench Width 36" Max Trench Bottom Depth 36" Gravel Depth

☑ New System ☐ Repair System Type: I, II, III, IV, V, VI
System Description: 2BM=LAUNDRY/TVE -25% Red.
Repair System Description: LP Panel/Blade
Maintenance Agreement Required: ☐ Yes ☑ No

☑ House/Mod. Home No. Bedrooms 4/4
☐ Mobile Home No. Bathrooms
☐ Business No. Employees
☐ Other


☑ Slab ☑ Crawl Space ☐ Basement w/plumbing ☐ Basement wo/plumbing

Water Supply: ☐ Individual ☑ Public ☑ Community

Comments/Conditions: Recommend EEE 222 Lay-HDS 2012 due to contour.

1"=50'


INITIAL SITE SKETCH

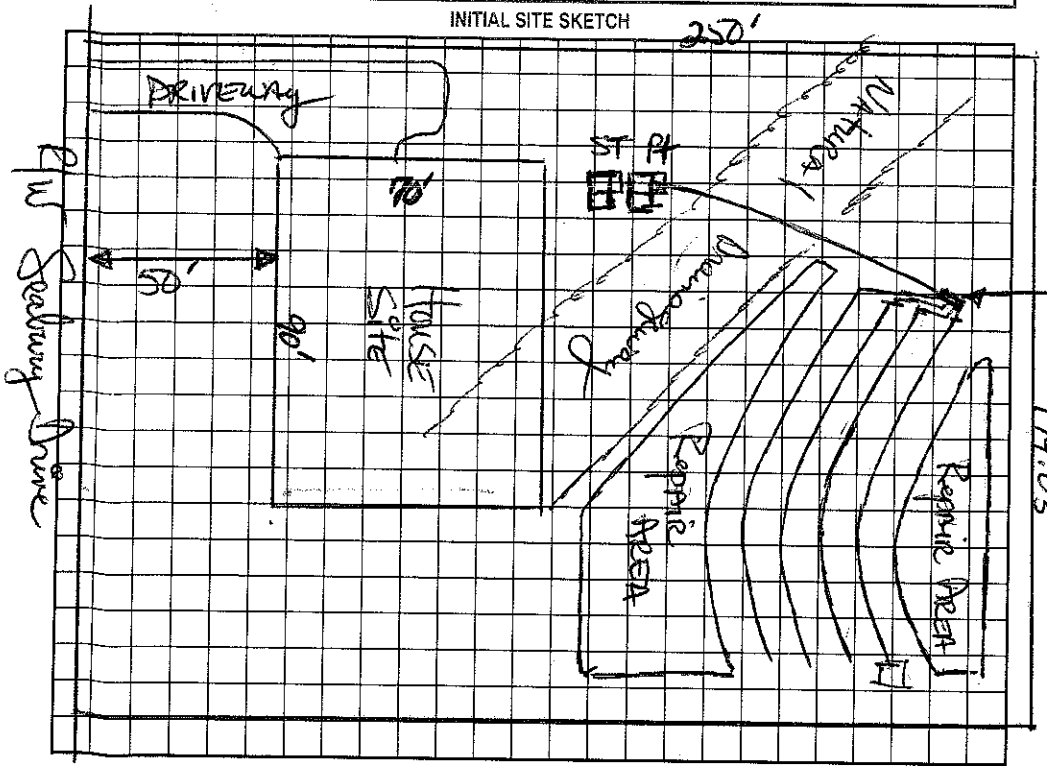

Comments/Conditions: Checked lines 8/11/04 MD
EZ Flow Drainfield installed MD
Pres. Electr. alarm 9/30/04 MD

AS BUILT SKETCH

See System Upgrade Issued 2/3/05

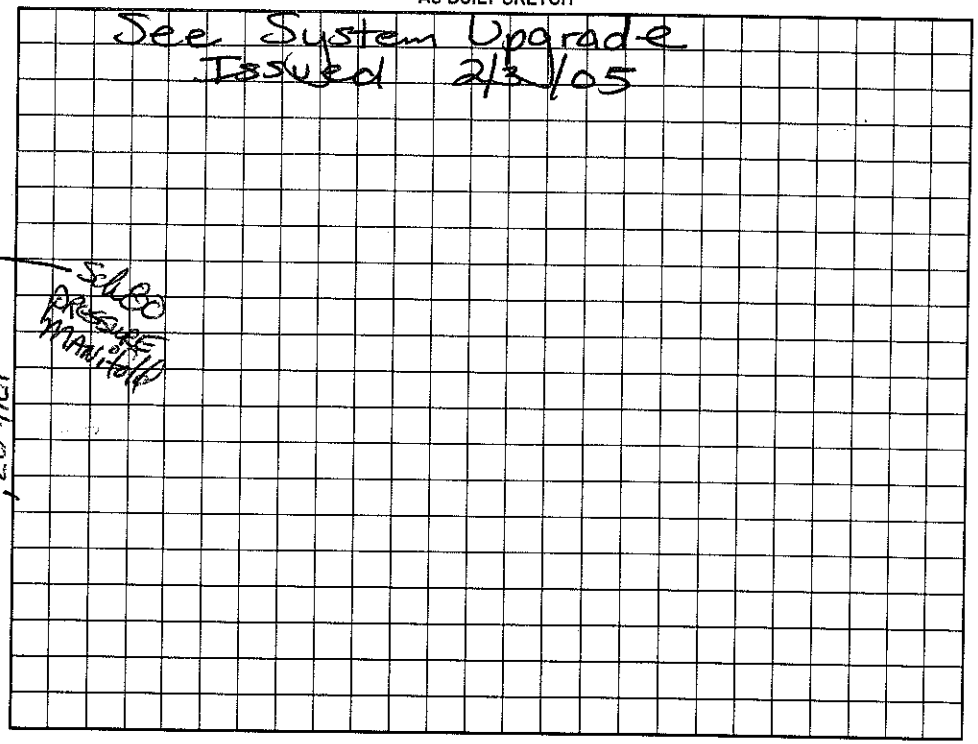

Permit can be suspended or revoked if any false information is supplied toward securing the permit/any unauthorized changes are made to the site/any unauthorized changes are made in the installation of the system. Improvement Permit with plat valid without expiration. Improvement Permit with site plan valid for sixty months. Authorization to Construct is valid for a period equal to that of Improvement Permit – not to exceed sixty months.

Signed: Paul C. Pam date 6-7-99
Improvement Permit by: date 6-7-99
Authorization to Construct by: date 12/12/03

Installed by: RET
Operation Permit by: Maina H. Watson RS date 9/30/04
Existing System Inspection by: date

HEALTH DEPT. COPY: WHITE OWNER COPY (FINAL): YELLOW OWNER COPY (INITIAL): PINK