IREDELL COUNTY HEALTH DEPARTMENT

STATESVILLE 704-878-3205 $125 MOORESVILLE 704-664-5281

IMPROVEMENT PERMIT / AUTHORIZATION TO CONSTRUCT / OPERATION PERMIT / EXISTING SYSTEM INSPECTION

PERMIT# 07864 PIN# 4625941684 (lot) Lake Norman Signature Homes 4626 92 5130 DATE June 7 '99

OWNER OR CONTRACTOR Grassmere Resources, Inc. The Point for Norman PHONE: Business 660-1185 Home

ADDRESS 2214 Brawley Sch Rd Statesville

LOCATION Brawley Sch Rd. TL Great Point Drive TL Wild Harbor Rd. TL Athenian Way TL Seabury Drive on left 121 Seabury Dr.

SUBDIVISION The Point BLOCK / SECTION III LOT 342 LOT AREA ~~44,505 SF~~ 31,800 SITE CLASS. PS DESIGN FLOW 480gpd E.T.A.R. .25-03

Septic Tank: 1000+ Gallons; STB 338 Date 12/15/61

Pump Tank: 1000 Gallons; PT 283 Date 11/1/01

Pump Make: Gould's Model 312-HC Serial No. D006068

Nitrification Field: No Fields 1 Square Feet 1320 Linear Feet 440

No Lines 4@110' Trench Width 36" Max Trench Bottom Depth 36" Gravel Depth N/A

☑ New System ☐ Repair System Type: I, II, III, IV, V, VI

System Description: PM - Innovative - 25% Reduction

Repair System Description: LP Panel Block

Maintenance Agreement Required: ☐ Yes ☑ No

☐ House ☐ Mobile Home ☐ Business ☐ Other

No. Bedrooms 4/4 No. Bathrooms 4/4 No. Employees

☑ Slab ☑ Crawl Space ☐ Basement w/plumbing ☐ Basement wo/plumbing


Water Supply: ☐ Individual ☑ Public ☐ Community

Comments:/Conditions: 5-30-01 Reviewed house plan appears substantially in compliance w/ IP. Locate house 50' BP front. Shift tanks to left side of house. DPH


Comments:/Conditions:

1"=50'

INITIAL SITE SKETCH

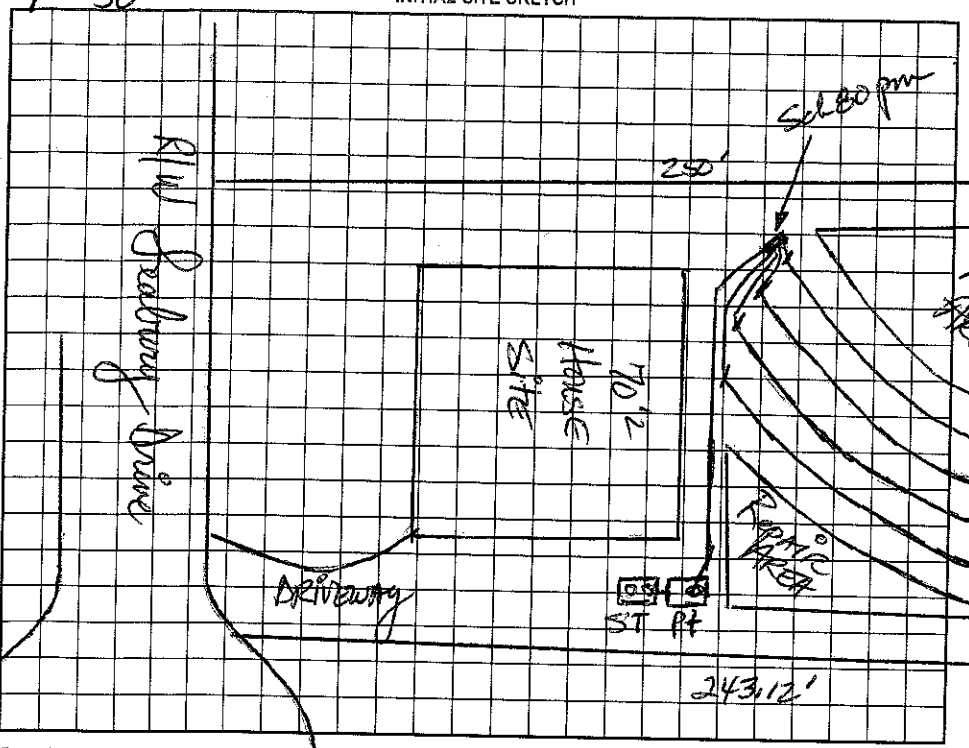

AS BUILT SKETCH

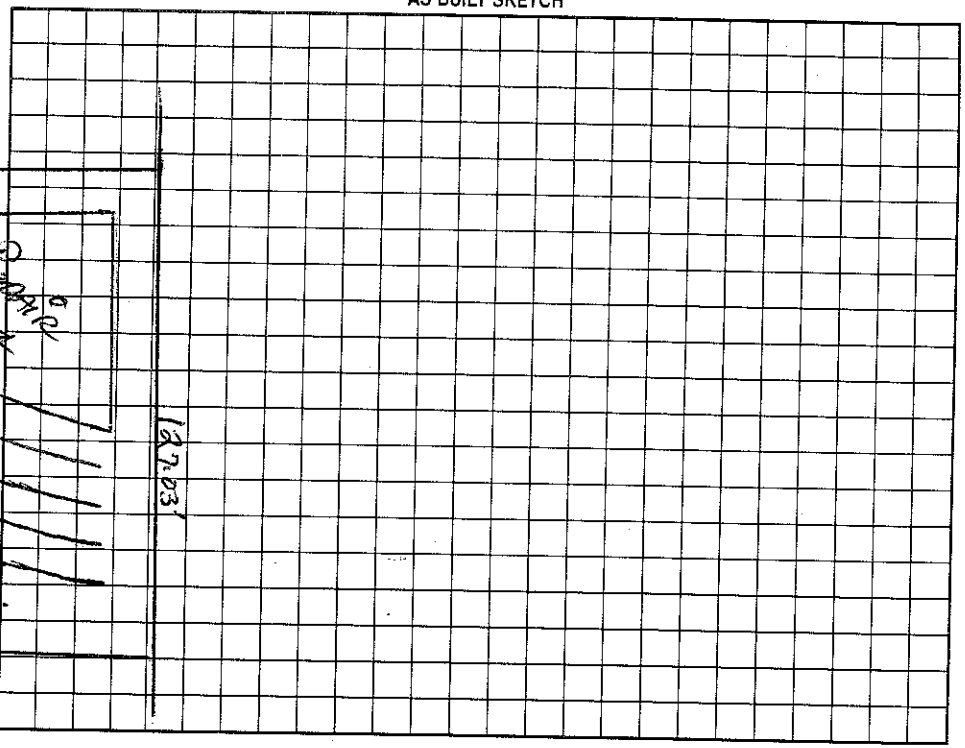

Permit can be suspended or revoked if any false information is supplied toward securing the permit/any unauthorized changes are made to the site/any unauthorized changes are made in the installation of the system. Improvement Permit with plat valid without expiration. Improvement Permit with site plan valid for sixty months. Authorization to Construct is valid for a period equal to that of Improvement Permit – not to exceed sixty months.

Signed: date 6-9-99

Improvement Permit by: date 6-7-99

Authorization to Construct by: date 5-30-01

Installed by: Hallmen Const.

Operation Permit by: RS date 2/5/02

Existing System Inspection by: date

HEALTH DEPT. COPY: WHITE OWNER COPY (FINAL): YELLOW OWNER COPY (INITIAL): PINK