125

# IREDELL COUNTY HEALTH DEPARTMENT

STATESVILLE 704-878-5305 MOORESVILLE 704-664-5281

## IMPROVEMENT PERMIT / AUTHORIZATION TO CONSTRUCT / OPERATION PERMIT / EXISTING SYSTEM INSPECTION

PERMIT# 078640 PIN# 4625941168 (pt.) DAVID DEBBLE Cus. Homes 4626927147 DATE May 12, '99

OWNER OR CONTRACTOR Crescent Resources Inc. (The Point) FOR NORMAN PHONE: Business 660-1185 Home

ADDRESS 2214 Brawley School Rd. Mooresville

LOCATION Brawley School Rd TL Great Point Dr. TL Wild Harbor Road TL Atlantic Way TL Seabury Drive AT END ON left

SUBDIVISION The Point BLOCK / SECTION III LOT 341 LOT AREA 48,259 sf SITE CLASS. 45 DESIGN FLOW 480 gpd L.T.A.R. no 3

Septic Tank: ~~1000~~ 1500 Gallons; STB 338 Date 11/4/04

Pump Tank: 1000 Gallons; PT 183 Date 11/17/04

Pump Make: Gould's Model WE20-511 Serial No.

Nitrification Field: No Fields 1 Square Feet 1650 Linear Feet 550

No Lines 5 @ 110' Trench Width 36" Max Trench Bottom Depth 36" Gravel Depth 12"

☑ New System ☐ Repair System Type: I, II, III, IV, V, VI

System Description: PM - CONVENTIONAL

Repair System Description: 2P INNOVATIVE

Maintenance Agreement Required: ☐ Yes ☑ No

☐ ~~House/Mod. Home~~ No. Bedrooms 4

☐ Mobile Home No. Bathrooms 4

☐ Business No. Employees

☐ Other

☑ Slab ☑ Crawl Space ☑ Basement w/plumbing ☐ Basement wo/plumbing


Water Supply: ☐ Individual ☐ ~~Public~~ ☐ ~~Community~~

Comments:/Conditions:


Sch 60 p.m.

Comments:/Conditions:

INITIAL SITE SKETCH

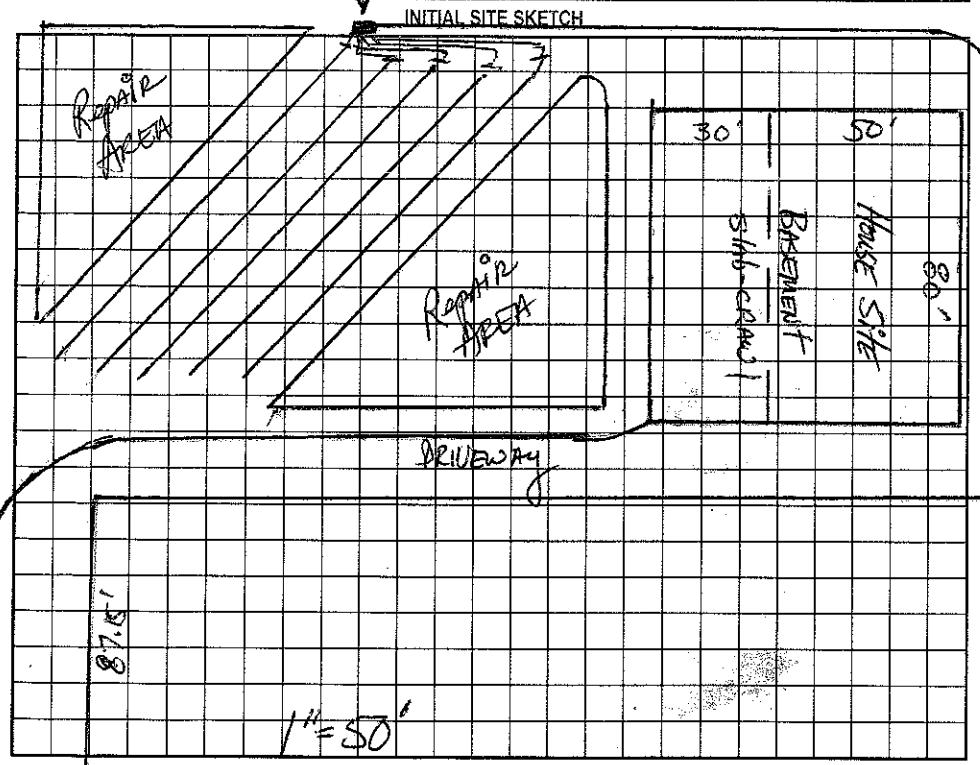


AS BUILT SKETCH

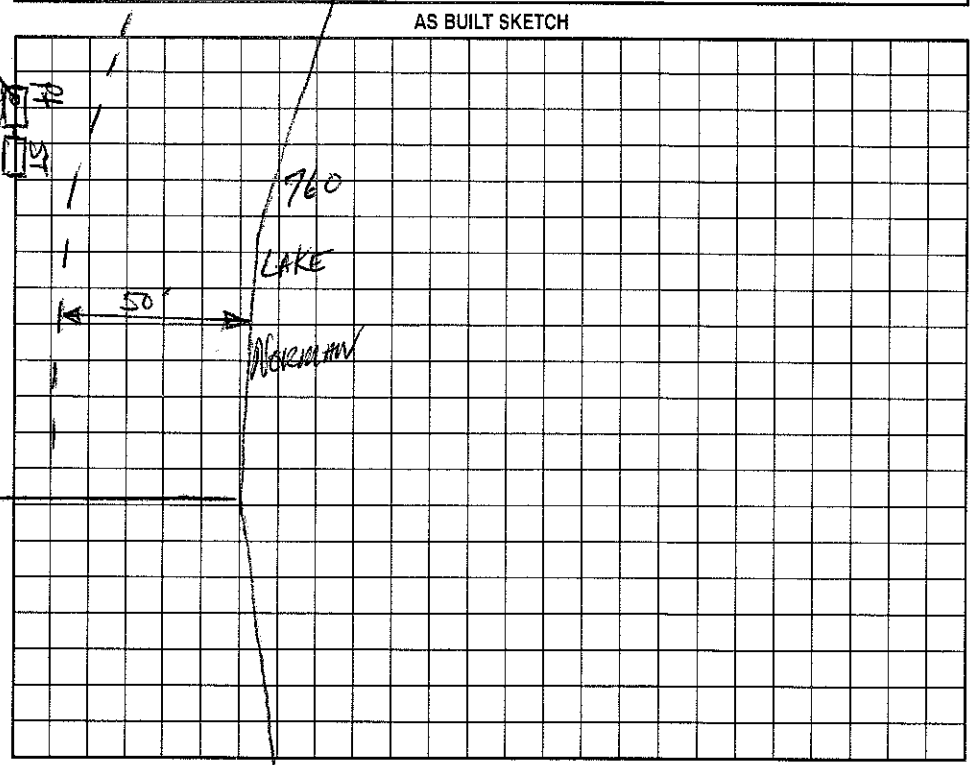


Permit can be suspended or revoked if any false information is supplied toward securing the permit/any unauthorized changes are made to the site/any unauthorized changes are made in the installation of the system. Improvement Permit with plat valid without expiration. Improvement Permit with site plan valid for sixty months. Authorization to Construct is valid for a period equal to that of Improvement Permit – not to exceed sixty months.

Signed: Paul G. Pennington date 5-14-99 Installed by: Dalsons Septic

Improvement Permit by: RS date 5-12-99 Operation Permit by: RS date 4/19/05

Authorization to Construct by: date 7/21/04 Existing System Inspection by: date

RW Seabury Drive

HEALTH DEPT. COPY: WHITE OWNER COPY (FINAL): YELLOW OWNER COPY (INITIAL): PINK