IREDELL COUNTY HEALTH DEPARTMENT

STATESVILLE 704-878-5305 MOORESVILLE 704-664-5281

IMPROVEMENT PERMIT / AUTHORIZATION TO CONSTRUCT / OPERATION PERMIT / EXISTING SYSTEM INSPECTION

PERMIT# 141685 PIN# 4626 93 1306 4626-93-2340 DATE 6/14/07

OWNER OR APPLICANT JAMES + PEGGY THOMPSON PHONE: Business Home 704-664-2535

ADDRESS 1457 BRAWLEY SCHOOL RD. MOORESVILLE, NC. 28117

LOCATION 1100 ON (L) PAST McKENDREE RD.

SUBDIVISION No BLOCK / SECTION LOT LOT AREA ~1.4 AC SITE CLASS. PS DESIGN FLOW 360 L.T.A.R. .3

Septic Tank: 1000 Gallons; STB 799 Date 5-5-07

Pump Tank: 1000 Gallons; PT 283 Date 10-9-07

Pump Make: Goulds Model WE05 Serial No.

Nitrification Field: No Fields 1 Square Feet 900 Linear Feet 300

No Lines 3@100' Trench Width 3' Max Trench Bottom Depth 3' Gravel Depth No ☐ Gravity ☒ Pressure ☐ Slab ☒ Crawl Space ☒ Basement w/plumbing ☐ Basement wo/plumbing

☒ New System ☐ Repair ☐ Expansion System Type: I II (III) IV V VI

System Description: DM → 2500 REDUCTION

Repair System Description: STONE

Maintenance Agreement Required: ☐ Yes ☐ No

☒ House/Mod. Home No. Bedrooms 3

☐ Mobile Home No. Persons

☐ Business No. Employees


☐ Other

Water Supply: ☒ Individual ☐ Public ☐ Community EXISTING

Comments/Conditions: Tanks must be 50' minimum from Well on this property. Hwy Relocation Project.


Comments/Conditions: 11/21/07 2# pressure set, tank & lines checked Supply line ~ 360 ft > 30 inches

INITIAL SITE SKETCH

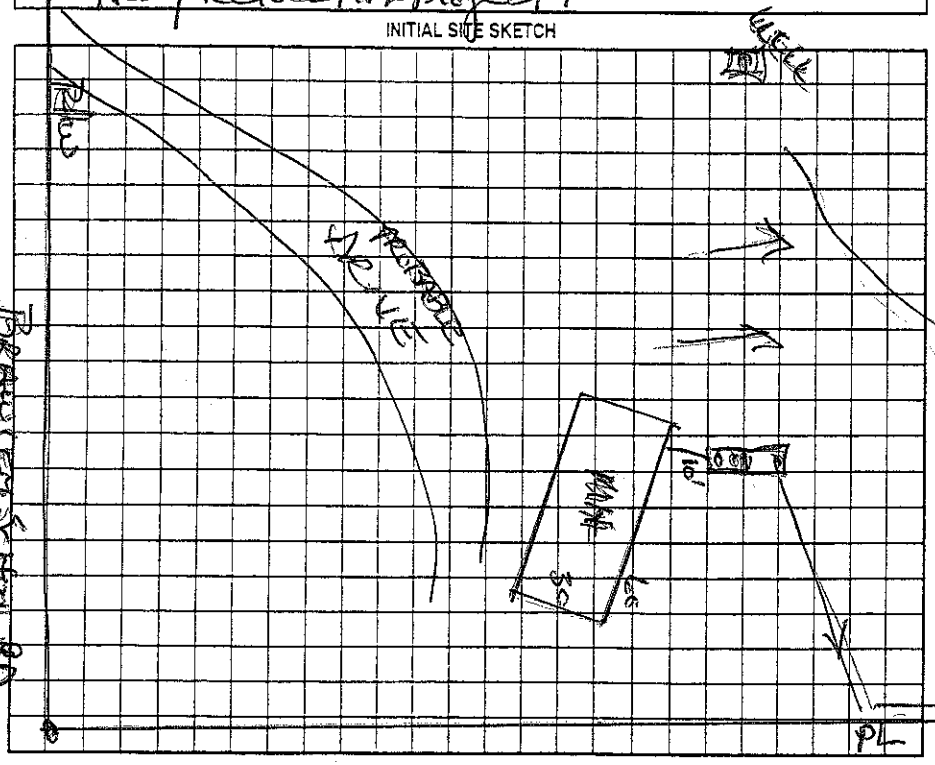

AS BUILT SKETCH

Installed Quick 4 as Drawn

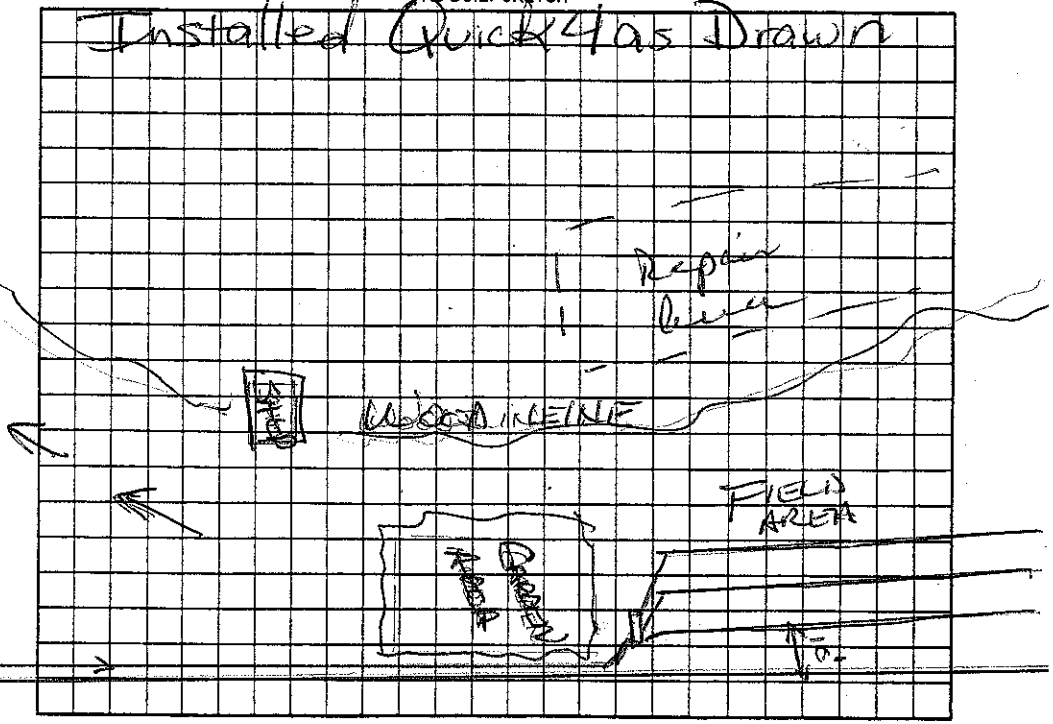

Permit can be suspended or revoked if any false information is supplied toward securing the permit/any unauthorized changes are made to the site/any unauthorized changes are made in the installation of the system. Improvement Permit with plat valid without expiration ☐ Improvement Permit with site plan valid for sixty months ☐ Authorization to Construct is valid for a period equal to that of Improvement Permit – not to exceed sixty months.

Signed: James L Thompson date

Improvement Permit by: Wesley Sparks RS date 6/14/07

Authorization to Construct by: Wesley Sparks RS date 6/14/07

Installed by: Larry Beam BS

Operation Permit by: Marion Hall Gibson BS date 1/16/08

Existing System Inspection by: date

HEALTH DEPT. COPY: WHITE OWNER COPY (FINAL): YELLOW OWNER COPY (INITIAL): PINK