IREDELL COUNTY HEALTH DEPARTMENT Existing

STATESVILLE 878-5305 MOORESVILLE 704-664-5281

IMPROVEMENT PERMIT / AUTHORIZATION TO CONSTRUCT / OPERATION PERMIT / EXISTING SYSTEM INSPECTIO

PERMIT# 141919 PIN# ~~4626937837~~ 4626 93 9715 DATE 7/30/07

OWNER OR CONTRACTOR Edith Thompson PHONE: Business 704-664-5335 Home

ADDRESS 407 Brawley School Rd Mooresville, NC 28117

LOCATION Brawley School Rd. 1407 Brawley School Rd.

SUBDIVISION BLOCK / SECTION LOT LOT AREA 28.29ac SITE CLASS. Existing DESIGN FLOW 240 L.T.A.R. 0.6gpd

Septic Tank: Ex. 1000 Gallons; STB Existing Date

Pump Tank: Gallons; PT Date

Pump Make: Model Serial No.

Nitrification Field: No Fields 1 Square Feet 570 Linear Feet 170' Existing

No Lines 3 Trench Width 36" Max Trench Bottom Depth Existing Gravel Depth 12"

☐ New System ☐ Repair System Type: I (II) III, IV, V, VI

System Description: Existing System

Repair System Description:

Maintenance Agreement Required: ☐ Yes ☐ No

☑ House/Mod. Home No. Bedrooms 2

☐ Mobile Home No. Bathrooms

☐ Business No. Employees

☐ Other

☐ Slab ☑ Crawl Space ☐ Basement w/plumbing ☐ Basement wo/plumbing


Water Supply: ☑ Individual ☐ Public ☐ Community

Comments:/Conditions:

Comments:/Conditions: House stubout must be set for gravity flow or a LPP pump will be required. No visible malfunction observed at time of inspection. See permit #363 "1984" Mrs. WW Thompson

INITIAL SITE SKETCH

AS BUILT SKETCH

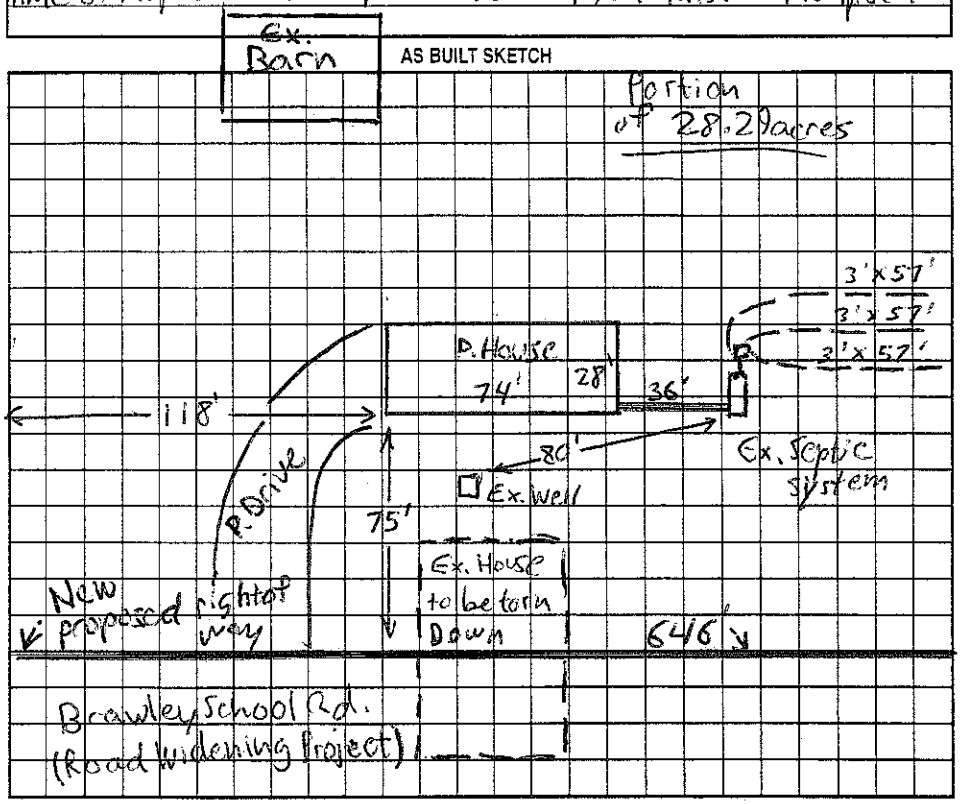

Permit can be suspended or revoked if any false information is supplied toward securing the permit/any unauthorized changes are made to the site/any unauthorized changes are made in the installation of the system. Improvement Permit with plat valid without expiration. Improvement Permit with site plan valid for sixty months. Authorization to Construct is valid for a period equal to that of Improvement Permit – not to exceed sixty months.

Signed: Elizabeth A Beard date 7-30-07 Installed by:

Improvement Permit by: date Operation Permit by: date

Authorization to Construct by: date Existing System Inspection by: Anthony Cohen Jr. date 7/30/07

HEALTH DEPT. COPY: WHITE OWNER COPY (FINAL): YELLOW OWNER COPY (INITIAL): PINK