IREDELL COUNTY HEALTH DEPARTMENT - *ENVIRONMENTAL HEALTH* ☐ STATESVILLE OFFICE 704-878-5305 ☒ MOORESVILLE OFFICE 704-664-5281

IMPROVEMENT PERMIT / AUTHORIZATION TO CONSTRUCT / OPERATION PERMIT / EXISTING SYSTEM INSPECTION

PERMIT # 169045 PIN # 4626-94-6680 DATE

OWNER RICHARD ABERNATHY APPLICANT: SAME PHONE: Home/Cell # 704-309-8625 Business #

SITE ADDRESS 1389 BRAWLEY SCHOOL RD OWNER / APPLICANT ADDRESS 1491 MT. ULLA HWY

SITE DIRECTIONS BSR, ACROSS FROM MCKENDREE RD

SUBDIVISION BLOCK / SECTION LOT # 1 LOT AREA .689 AC DESIGN FLOW 360 L.T.A.R. .3

Septic Tank EX. 1000 Gallons: STB Date

Pump Tank Gallons: P T Date

Pump Make Model Serial #

No. Nitrification Fields: No. Lines Linear Feet

Trench Width EXISTING Max. Trench Bottom Depth Gravel Depth

☐ New System ☐ Repair ☐ Expansion System Type I II III IV V VI

System Description: CONVENTIONAL

Repair System Description: SAME

Maintenance Agreement Required ☐ YES ☒ NO

☒ GRAVITY ☐ PRESSURE

☒ Residence No. Bedrooms 3

☐ Business No. Persons

☐ Other No. Employees

☐ Slab ☒ Crawl Space

☐ Basement w/plumbing ☐ Basement w/o plumbing

Water Supply


☒ Private

☐ Public


☐ Community

Comments / Conditions ① SYSTEM GOOD @ TIME OF INSPECTION

INITIAL SITE SKETCH

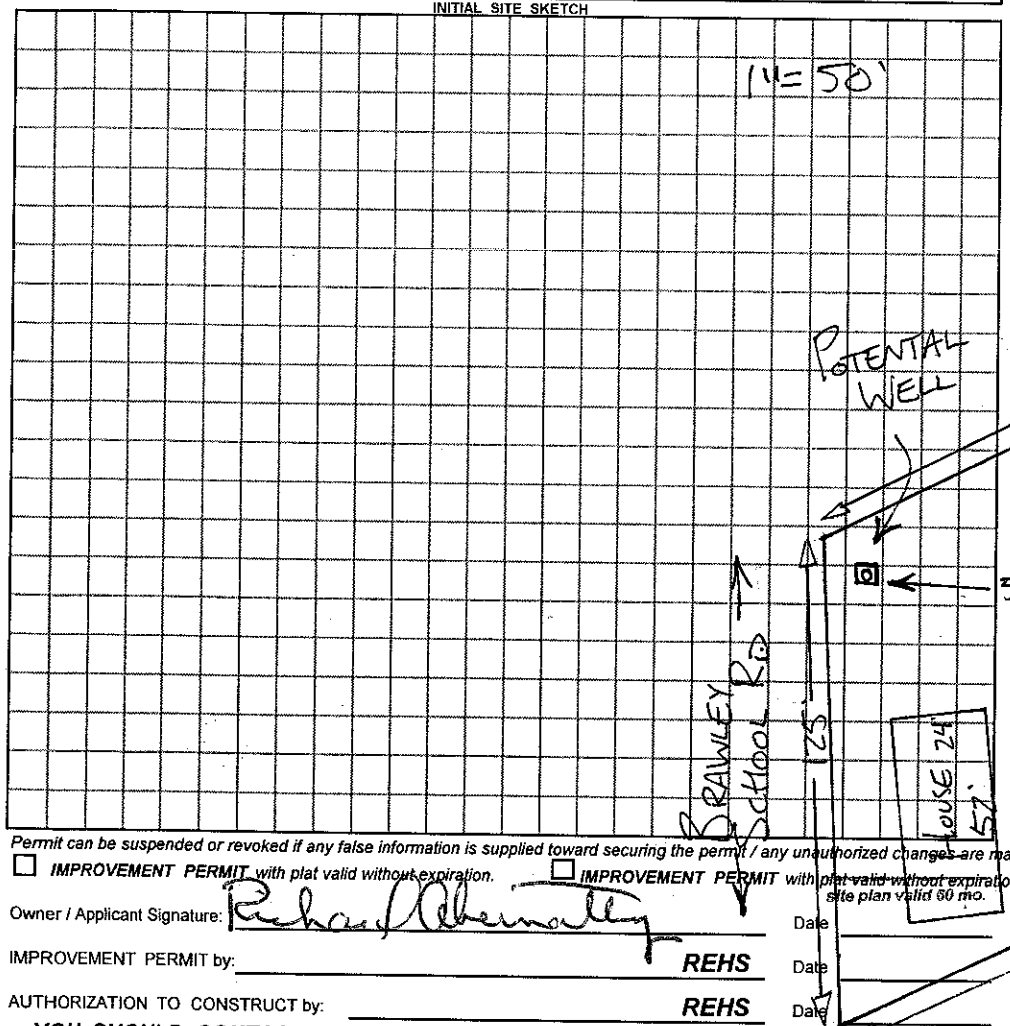

AS BUILT SKETCH

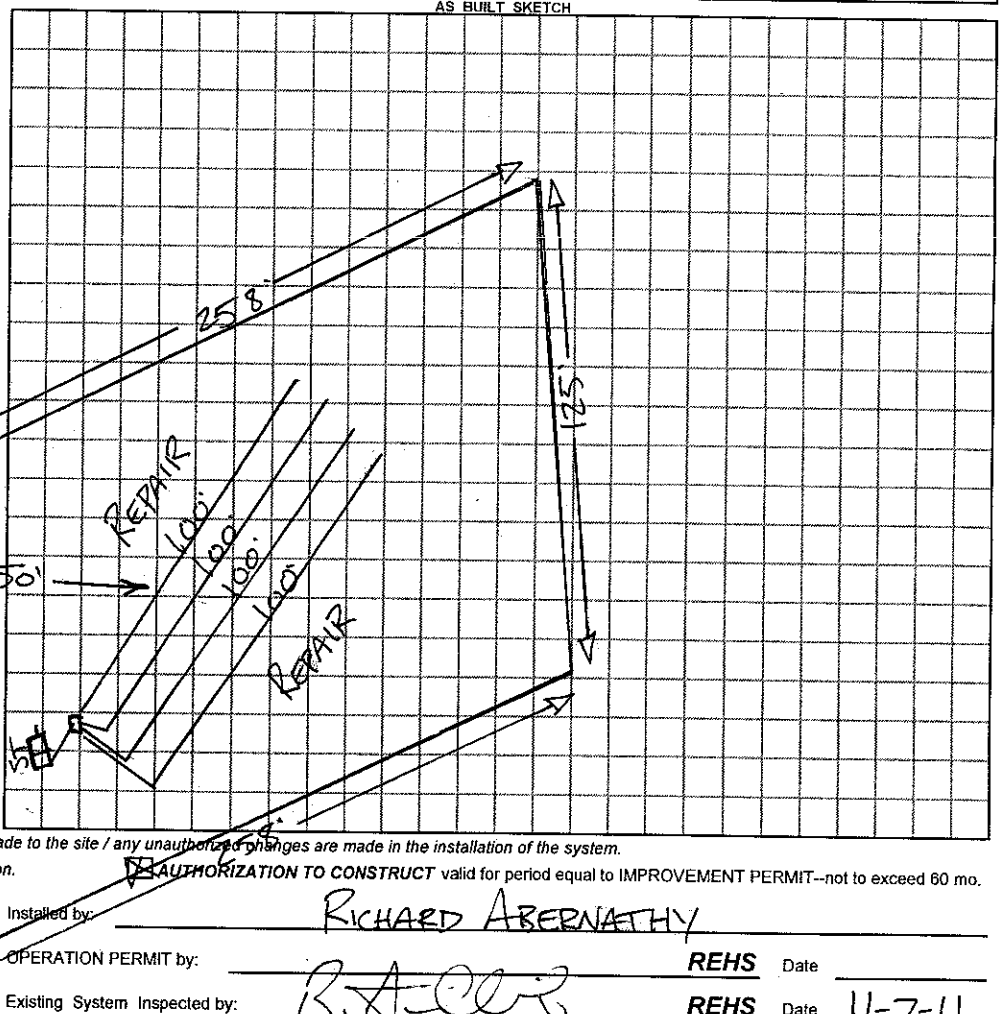

Permit can be suspended or revoked if any false information is supplied toward securing the permit / any unauthorized changes are made to the site / any unauthorized changes are made in the installation of the system.

☐ ***IMPROVEMENT PERMIT*** with plat valid without expiration. ☐ ***IMPROVEMENT PERMIT*** with ~~plat valid without expiration.~~ site plan valid 60 mo. ☒ ***AUTHORIZATION TO CONSTRUCT*** valid for period equal to IMPROVEMENT PERMIT--not to exceed 60 mo.

Owner / Applicant Signature: Richard Abernathy Date

IMPROVEMENT PERMIT by: ***REHS*** Date

AUTHORIZATION TO CONSTRUCT by: ***REHS*** Date

YOU SHOULD CONTACT A LOCATOR SERVICE PRIOR TO ANY EXCAVATION

Installed by: RICHARD ABERNATHY

OPERATION PERMIT by: ***REHS*** Date

Existing System Inspected by: B. A. ***REHS*** Date 11-7-11

White Copy – Environmental Health YELLOW COPY (Final) Owner / Applicant PINK COPY (Initial) Owner / Applicant