PAID $485.00 1-4-11 pmw gm

IREDELL COUNTY HEALTH DEPARTMENT

STATESVILLE 704-878-5305 MOORESVILLE 704-664-5281

IMPROVEMENT PERMIT / AUTHORIZATION TO CONSTRUCT / OPERATION PERMIT / EXISTING SYSTEM INSPECTION

PERMIT # 1641164 PIN # 4626-94-9478 DATE 1-3-11

OWNER or APPLICANT RICHARD ABERNATHY PHONE: Business 704-309-8625 Home:

OWNER or APPLICANT ADDRESS 1491 MOUNT ULLA HWY MOUNT ULLA NC 28125

LOCATION / DIRECTIONS 1397 BSR, ACROSS FROM McKENDREE RD

SUBDIVISION BLOCK / SECTION LOT # LOT AREA 9.408AC DESIGN FLOW 360 GPD L.T.A.R. .3

Septic Tank 1000 Gallons: STB Date

Pump Tank Gallons: P T Date

Pump Make Model Serial #

Nitrification Field No Fields No Lines 5 Linear Feet 260'

Trench Width 36" Max. Trench Bottom Depth ~~24"~~ 29" Gravel Depth

☒ New System ☐ Repair ☐ Expansion System Type I (II) III IV V VI

System Description: TANK

Repair System Description: 25% RED.

Maintenance Agreement Required ☐ YES ☒ NO

☒ GRAVITY ☐ PRESSURE

☒ Residence No. Bedrooms 3

☐ Business No. Persons

☐ Other No. Employees

☐ Slab ☒ Crawl Space


☐ Basement w/plumbing ☐ Basement w/o plumbing

Water Supply: ☒ Private ☐ Public ☐ Community


Comments / Conditions ① INSTALL 1000 GAL TANK AS SHOWN ② TANK MAY BE MOVED SO LONG AS 50' WELL SEPERATION IS MAINTAINED

Comments / Conditions USE 29" TRENCH BOTTOM TO STAY OUT OF SAPROLITE

INITIAL SITE SKETCH

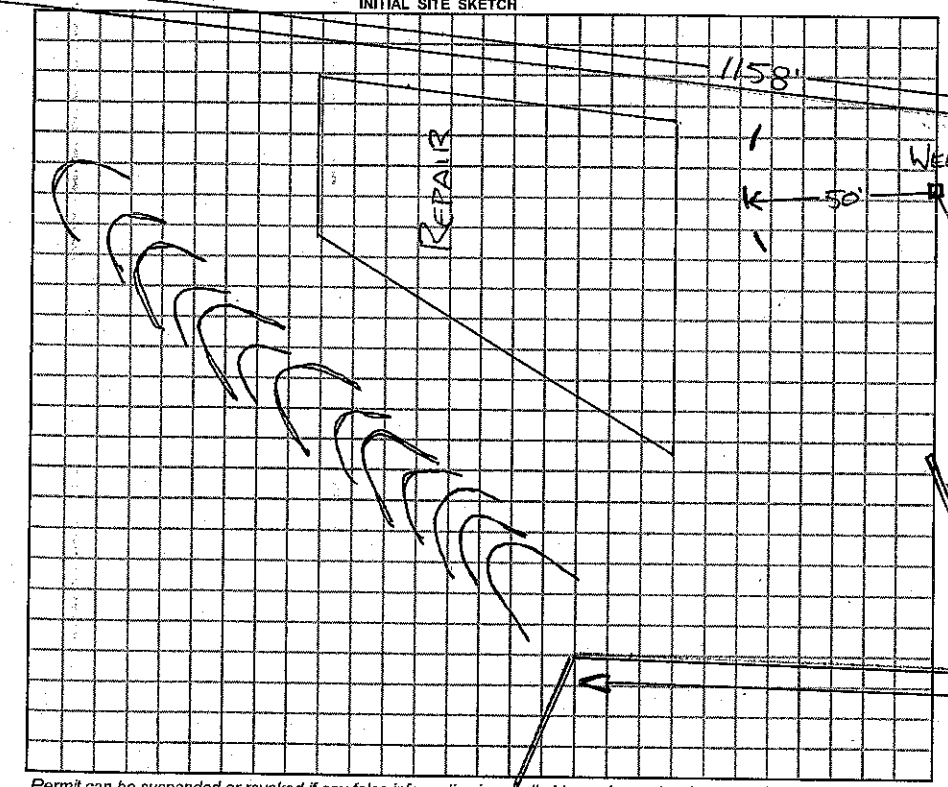

AS BUILT SKETCH

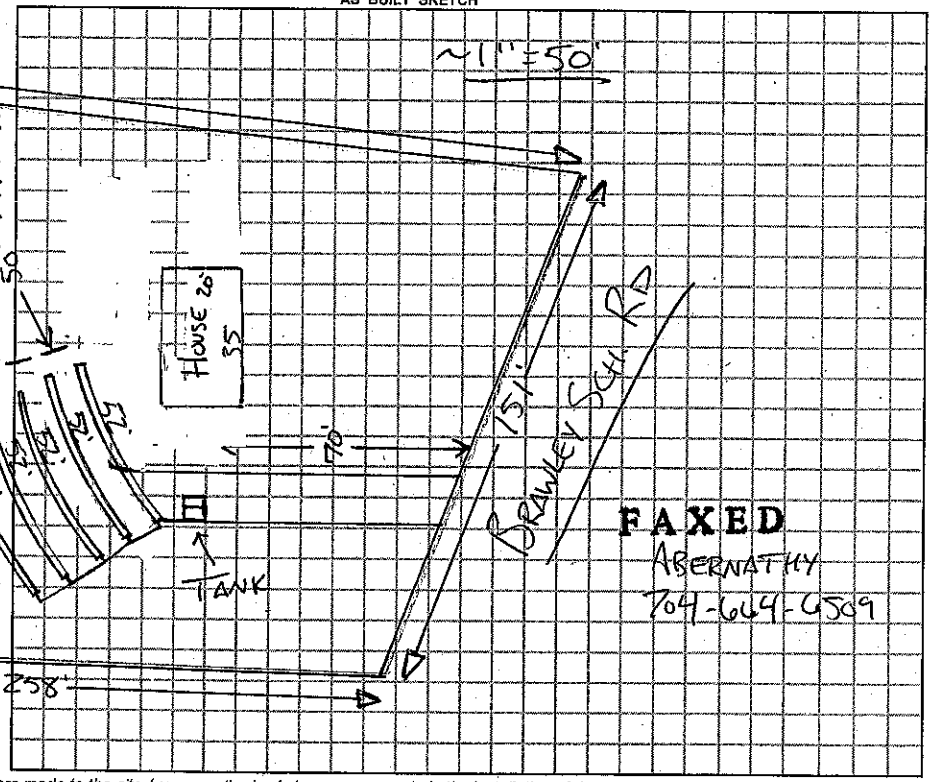

FAXED ABERNATHY 704-664-9509

Permit can be suspended or revoked if any false information is supplied toward securing the permit / any unauthorized changes are made to the site / any unauthorized changes are made in the installation of the system.

☐ *IMPROVEMENT PERMIT w / plat valid without expiration* ☒ *IMPROVEMENT PERMIT w / site plan valid for 60 mos.*

☒ *AUTHORIZATION TO CONSTRUCT valid for period equal to IMPROVEMENT PERMIT-not to exceed 60 mo.*

Owner / Applicant Signature: Richard Abernathy Date 1-3-11

Improvement Permit by: JRA REHS Date 1-3-10

Authorization to Construct by: JRA REHS Date 1-3-10

Installed by:

Operation Permit by: Date:

Existing System Inspected by: Date:

YOU SHOULD CONTACT A LOCATOR SERVICE PRIOR TO ANY EXCAVATION.

WHITE COPY Environmental Health YELLOW COPY (Final) Owner / Applicant PINK COPY (Initial) Owner / Applicant