9:30

IREDELL COUNTY HEALTH DEPARTMENT

STATESVILLE 704-878-5305 MOORESVILLE 704-664-5281

IMPROVEMENT PERMIT / CERTIFICATE OF COMPLETION / OPERATION PERMIT / EXISTING SYSTEM INSPECTION

PROPERTY DESCRIPTION NO. ~~3E 11A 45~~ 23392 DATE 4/2/96 TAX MAP NO. 2E 11A 45 Watershed: X Yes ☐ No

OWNER OR CONTRACTOR Ron H Waldron PHONE: Business 664-1490 Home 4626-95-2987

ADDRESS 195 Hancock Rd. Mooresville, NC. 28115

LOCATION Tawny Bark Rd, Brandy Jack Rd. TR Poplar Grove TR Tawny Bark ~ 5 lot on (R)

SUBDIVISION Poplar Grove BLOCK / SECTION ____ LOT 45 LOT AREA ~1.65ac SITE CLASS. PS DESIGN FLOW 360 L.T.A.R. .3

Septic Tank: 1000 Gallons; STB ____ Date 11/15/96

Pump Tank: ____ Gallons; PT ____ Date ____

Pump Make: ____ Model ____ Serial No. ____

Nitrification Field: No Fields 1 Square Feet 1200 Linear Feet 400

No Lines 4 Trench Width 36" Max Trench Bottom Depth 36" Gravel Depth 12"

X New System ☐ Repair System Type: I. II. III. IV. V. VI

System Description Shasty Conventional

Repair System Description: ____

Maintenance Agreement Required: ☐ Yes ☐ No

X House/Mod. Home No. Bedrooms 3

☐ Mobile Home No. Bathrooms 2.5

☐ Business No. Employees ____

☐ Other ____


☐ Slab X Crawl Space ☐ Basement w/plumbing ☐ Basement wo/plumbing

Water Supply:
X Individual
☐ Community
☐ Public


Comments:

Comments:

INITIAL SITE SKETCH

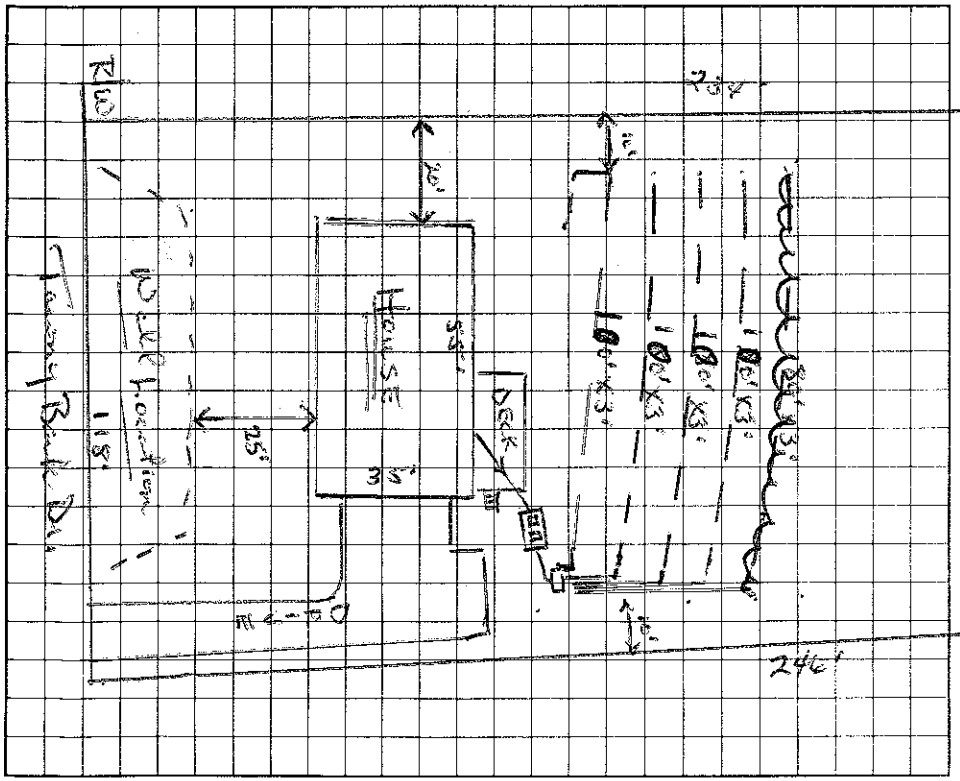

AS BUILT SKETCH

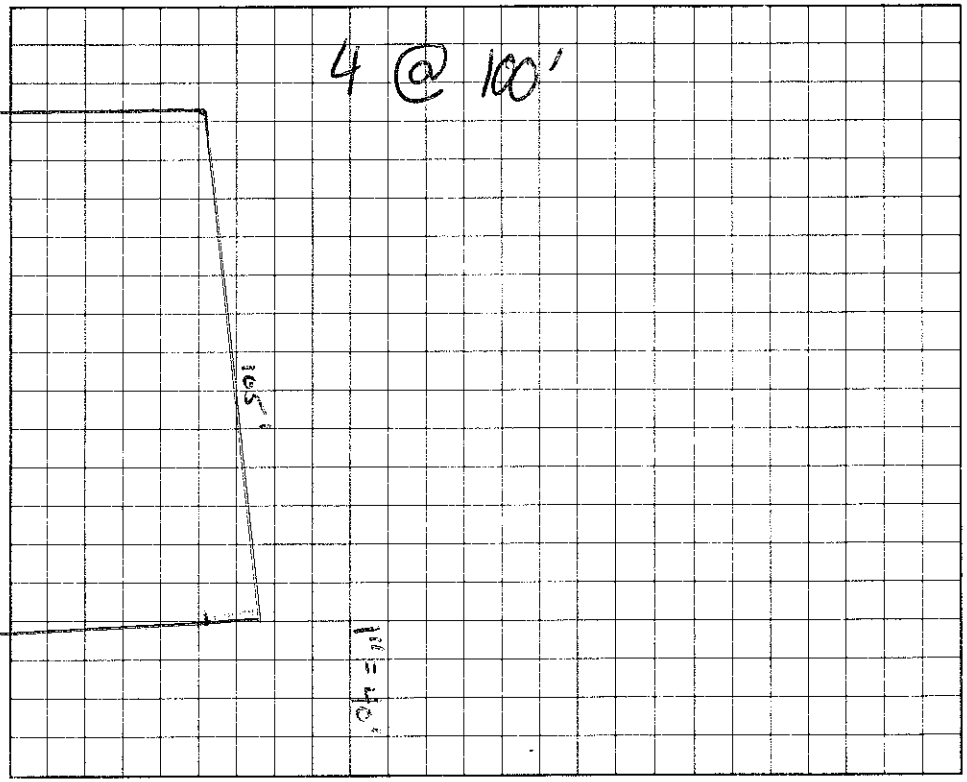

I understand that this permit can be suspended or revoked if any false information is supplied toward securing the permit/any unauthorized changes are made to the site/any unauthorized changes are made in the installation of the system.

Authorization to Construct valid for 5 years.

Signed: X Ronald H. Waldron

Improvement Permit by: Wesley Sparks R.S. date 4/2/96

Authorization to Construct: Wesley Sparks R.S. date 4/2/96

Existing System Inspection by: ____ date ____

Installed by: LAVON BENTON

Certificate of Completion by: ____ date ____

Operation Permit by: C. Eby Thomas EHST date 10/30/96

HEALTH DEPT. COPY: WHITE INSPECTION COPY (FINAL): GREEN OWNER COPY (FINAL): YELLOW INSPECTION COPY (INITIAL): PINK OWNER COPY (INITIAL): GOLD