IREDELL COUNTY HEALTH DEPARTMENT

Statesville Office (704) 878-5305 Mooresville Office (704) 660-3625 PERMIT # 20794S

IMPROVEMENT PERMIT / AUTHORIZATION TO CONSTRUCT / OPERATION PERMIT / EXISTING SYSTEM

PIN # 4626-95-5658

APPLICANT: LILLIAN JOHNSON APPLICANT ADDRESS: 116 POPLAR GROVE RD MOORESVILLE NC

SITE ADDRESS: 1360 BRAWLEY SCHOOL RD PHONE: 704-996-1442 ALT. PHONE:

SITE DIRECTIONS: BRAWLEY SCH RD, LOT ON R BEFORE POPLAR GROVE RD

SUBDIVISION: SECTION: LOT # LOT AREA: 5.45ac DESIGN FLOW: 750 gpd L.T.A.R.: 0.35(I) 0.25(R)

Septic Tank	1500 (gal)	STB	444	Date	7-20-15	☑ New System ☐ Repair ☐ Expansion	System Type: I II III IV V VI	☐ Residence	No. Bedrooms
Pump Tank	1000 (gal)	PT	783	Date	7-20-15	System Description:	PM 25% REDUCTION	☐ Business	No. Persons 150
Pump Make		Model		Serial #		Repair System Description:	LP PPBPS	☑ Other COVERED PAVILION	No. Employees
# Nitrification Fields	1	# Lines	6	Linear Ft:	545'	Maintenance Agreement Required:	☐ YES ☑ NO	☐ Slab	☐ Crawl Space
Trench Width	36"	Max. Trench Bottom Depth	25"	Gravel Depth	N/A		☐ GRAVITY ☑ PRESSURE	☐ Basement w/plumbing	☐ Basement w/o plumbing


Water Supply: ☑ Private ☐ Public ☐ Community

Comments / Conditions: KEEP LINES 15' FROM CUT, RUN SUPPLY LINE AS CLOSE AS POSSIBLE TO HORSE RIDING ARENA ON DRIVEWAY SIDE, REROUTE GUTTER DRAINS IN REPAIR AREA TO PROPERTY LINE, SOME FILL ON REPAIR AREA MAY NEED TO BE REMOVED BEFORE


CHECKED DRAINFIELD & TANKS 8-20-15 RA

CHECKED SUPPLY LINE 8-27-15 RA

INITIAL SITE SKETCH

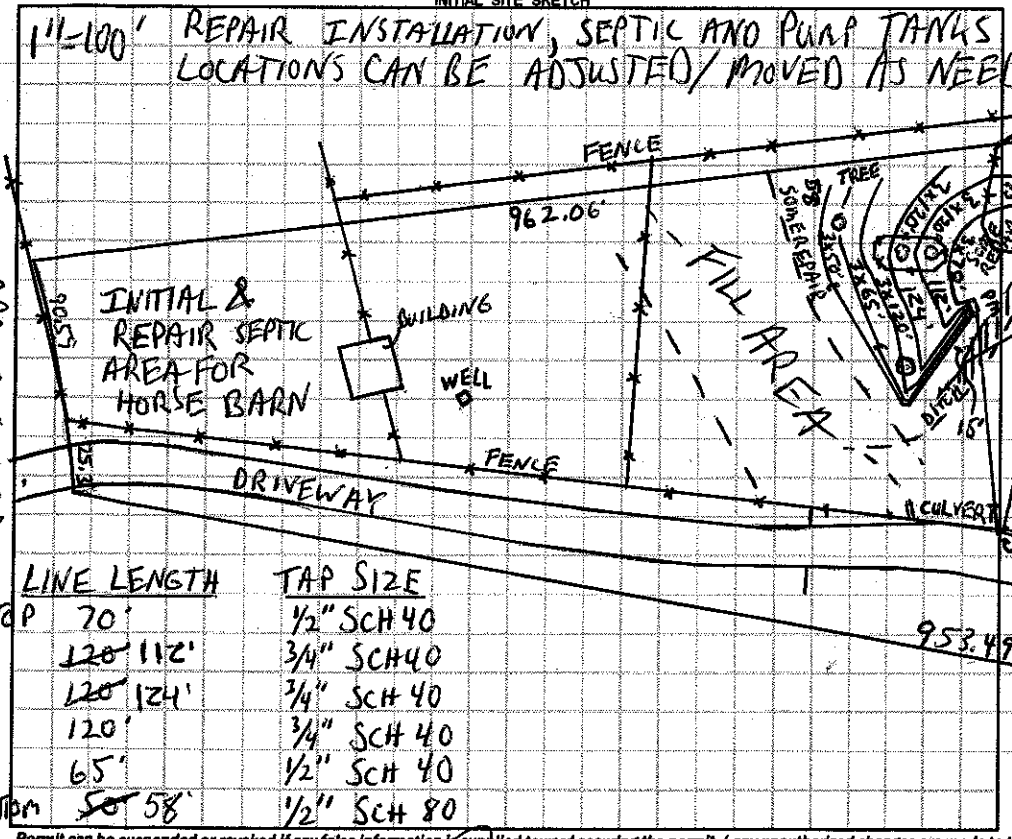

AS BUILT SKETCH

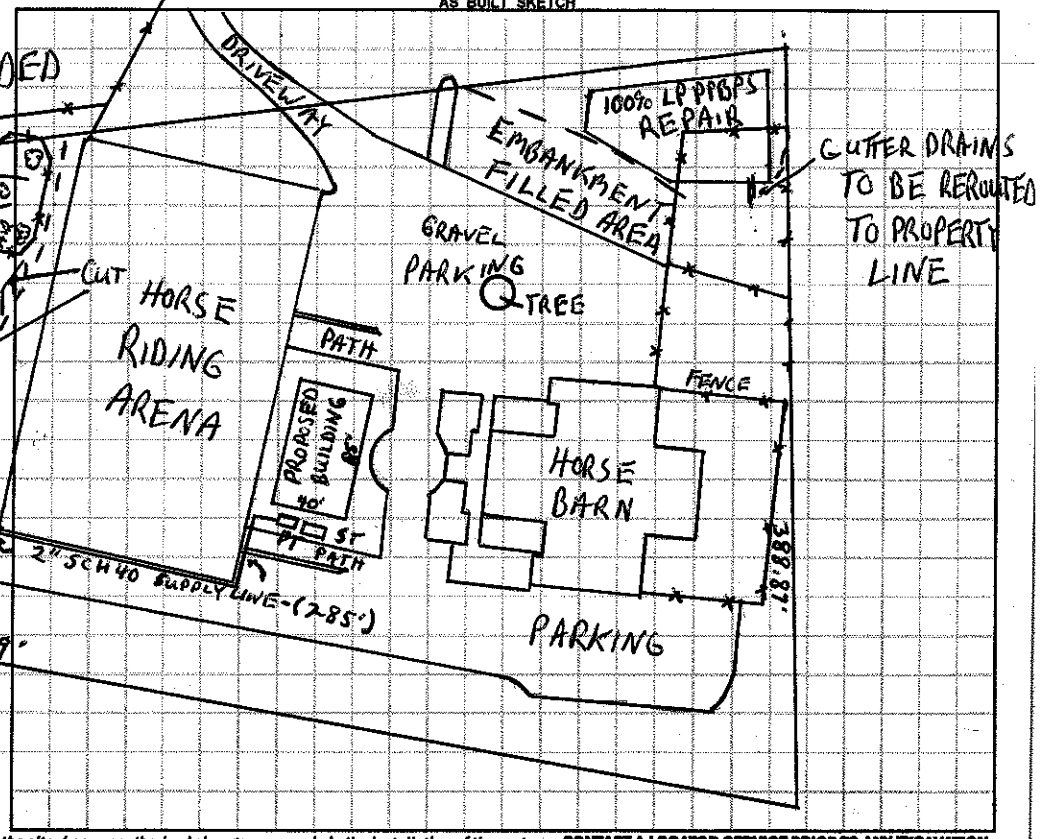

Permit can be suspended or revoked if any false information is supplied toward securing the permit / any unauthorized changes are made to the site / any unauthorized changes are made in the installation of the system. **CONTACT A LOCATOR SERVICE PRIOR TO ANY EXCAVATION**

☐ **IMPROVEMENT PERMIT** *with plat valid without expiration.* ☑ **IMPROVEMENT PERMIT** *with site plan valid for 60 mos.* ☑ **AUTHORIZATION TO CONSTRUCT** *valid for period equal to IMPROVEMENT PERMIT--not to exceed 60 mo.*

Owner / Applicant Signature: Lillian Johnson Date: 3-6-15 Installed by: Richard Abernathy

IMPROVEMENT PERMIT by: Date: 3-5-15 OPERATION PERMIT by: Date: 9/4/15

AUTHORIZATION TO CONSTRUCT by: Date: 3-5-15 Existing System Inspected by: Date:

Health Dept. Copy - WHITE Applicant (Final Approval) - YELLOW Applicant (Conditional Approval) - PINK