IREDELL COUNTY HEALTH DEPARTMENT

STATESVILLE 704-878-5305 MOORESVILLE 704-664-5281

IMPROVEMENT PERMIT / AUTHORIZATION TO CONSTRUCT / OPERATION PERMIT / EXISTING SYSTEM INSPECTION

PERMIT# D.O.T. Relocation PIN# 4626-95-9313 DATE 5-2-07

OWNER OR APPLICANT Lester Watts PHONE: Business _____ Home _____

ADDRESS 1354 Brawley School Road Mooresville NC 28117

LOCATION Brawley Sch. Rd, on Right past

SUBDIVISION _____ BLOCK / SECTION _____ LOT _____ LOT AREA ~2.5 Acres SITE CLASS. PS DESIGN FLOW 480 gpd L.T.A.R. .30 gpd/ft²

Septic Tank: 1000 Gallons; STB 194 Date 5-6-07
Pump Tank: _____ Gallons; PT _____ Date _____
Pump Make: _____ Model _____ Serial No. _____
Nitrification Field: No Fields 1 Square Feet 1200 Linear Feet 400'
No Lines 5 Trench Width 3' Max Trench Bottom Depth 36 inches

☐ New System ☐ Repair ☐ Expansion System Type: I II III IV V VI
System Description: Gravity - 25% Reduced
Repair System Description: LP Panel / 25% Red
Maintenance Agreement Required: ☐ Yes ☒ No

☒ House/Mod. Home No. Bedrooms 4
☐ Mobile Home No. Persons ___
☐ Business No. Employees ___
☐ Other ___


Water Supply: ☒ Individual ☐ Public ☐ Community

Gravel Depth ___ ☒ Gravity ☐ Pressure ☐ Slab ☒ Crawl Space ☐ Basement w/plumbing ☐ Basement wo/plumbing

Comments/Conditions: D.O.T Relocation Permit; 1) 1-2% slope in drainfield area - lines can go in on flat contour 2) remove, unhook, & or crush and fill in old existing tank +100% and tie plumbing into new septic tank

Comments/Conditions: 3) Install around old large trees if possible, remove trees if necessary as shown 4) New property line on Parcel due to new DOT right-of-way

INITIAL SITE SKETCH

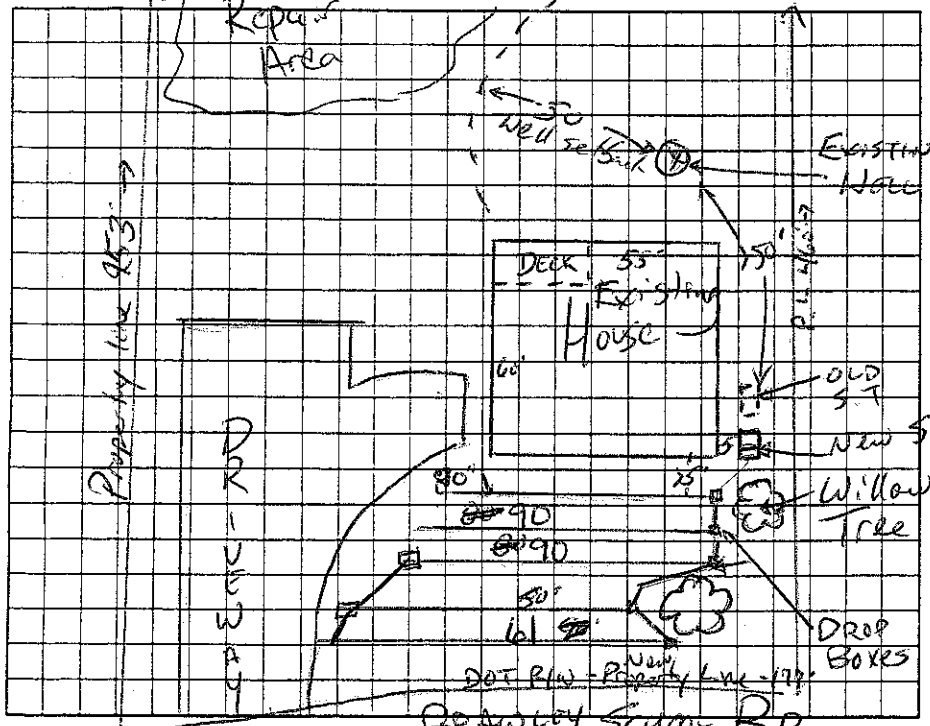

AS BUILT SKETCH

Note: 1st 3 lines feed on ST side lower 2 lines feed from opposite side.

Installed Quick 4 Drainfield, essentially as Drawn

Note: ST half Full after 1 day

Permit can be suspended or revoked if any false information is supplied toward securing the permit/any unauthorized changes are made to the site/any unauthorized changes are made in the installation of the system. Improvement Permit with plat valid without expiration ☐ Improvement Permit with site plan valid for sixty months ☒ Authorization to Construct is valid for a period equal to that of Improvement Permit – not to exceed sixty months.

Signed: Lester E Watts date 5-4-07 Installed by: Richard Abernathy RS

Improvement Permit by: John E Ellis date 5-2-07 Operation Permit by: Maria H Nolan RS date 6/14/07

Authorization to Construct by: John E Ellis date 5-2-07 Existing System Inspection by: _____ date _____

HEALTH DEPT. COPY: WHITE OWNER COPY (FINAL): YELLOW OWNER COPY (INITIAL): PINK