IREDELL COUNTY HEALTH DEPARTMENT

AUTHORIZATION TO CONSTRUCT 10:00

STATESVILLE 704-878-5305 MOORESVILLE 704-664-5281

IMPROVEMENT PERMIT / ~~CERTIFICATE OF COMPLETION~~ / OPERATION PERMIT / EXISTING SYSTEM INSPECTION

PROPERTY DESCRIPTION NO. 23508 DATE 11/12/97 TAX MAP NO. 2F-11-A-14 Watershed: ☑ Yes ☐ No

OWNER OR CONTRACTOR TONY KRALOVIC PHONE: Business _____ Home 662-9858

ADDRESS 202 DIGH CIRCLE · MOORESVILLE NC 28115 46026-96-0131

LOCATION BRAWLEY SCH. - TR POPLAR GROVE - TR TAWNY BARK DR - TL TALL OAK - ON CORNER

SUBDIVISION POPLAR GROVE BLOCK / SECTION - LOT 14 LOT AREA - SITE CLASS. PS DESIGN FLOW 360 GPD L.T.A.R. .3 GAD/FT²

Septic Tank: 1000 Gallons; STB 794 Date 12/16/98

Pump Tank: _____ Gallons; PT _____ Date _____

Pump Make: _____ Model _____ Serial No. _____

Nitrification Field: No Fields 1 Square Feet 900 Linear Feet 300

No Lines 4@75' Trench Width 36" Max Trench Bottom Depth 36" Gravel Depth N/A

☑ New System ☐ Repair System Type: I, II, III, IV, V, VI

System Description: GRAVITY CHAMBERED DRAINS

Repair System Description: PANEL

Maintenance Agreement Required: ☐ Yes ☑ No

☑ House/Mod. Home No. Bedrooms 3

☐ Mobile Home No. Bathrooms 3

☐ Business No. Employees _____

☐ Other _____


☐ Slab ☑ Crawl Space ☐ Basement w/plumbing ☐ Basement wo/plumbing

Water Supply: ☑ Individual ☐ Community ☐ Public

Comments: TANK CHANGED TO OTHER SIDE

Comments:

INITIAL SITE SKETCH 1"=40'

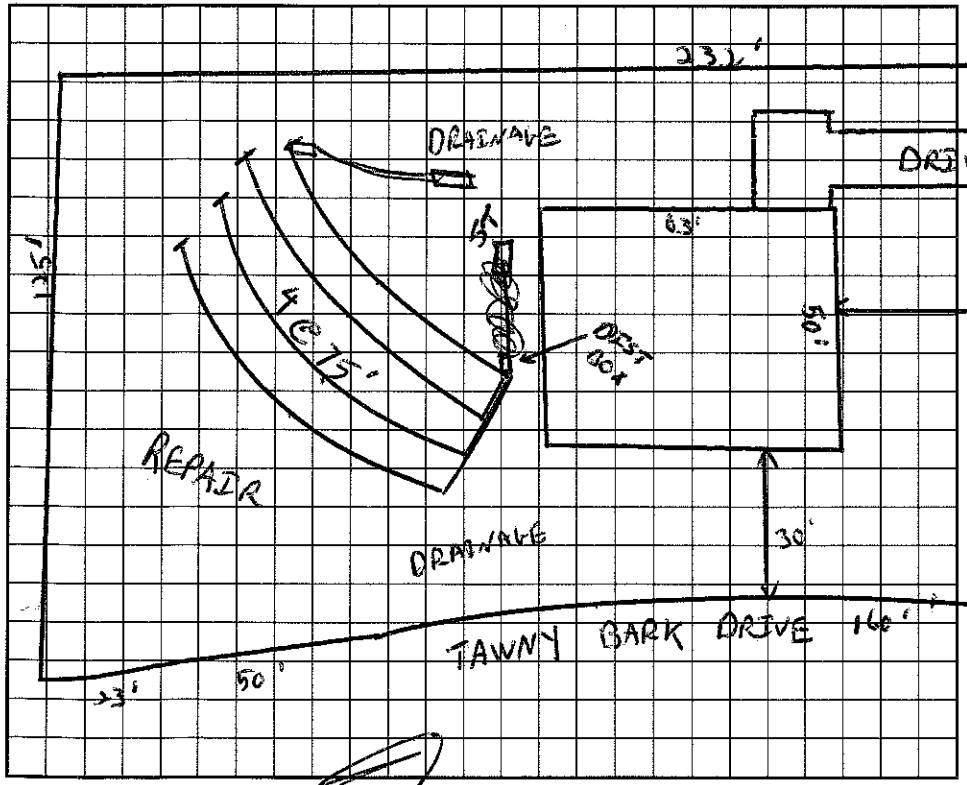

AS BUILT SKETCH

I understand that this permit can be suspended or revoked if any false information is supplied toward securing the permit/any unauthorized changes are made to the site/any unauthorized changes are made in the installation of the system. Improvement Permit is valid for 60 months from date of issuance.

Signed: _____

Installed by: LARRY BEAM

Improvement Permit by: C. Ray Thomas RS date 11/13/97

Certificate of Completion by: _____ date _____

~~Existing System Inspection by~~ AUTHORIZATION TO CONSTRUCT: C. Ray Thomas RS date 11/13/97

Operation Permit by: C. Ray Thomas RS date 2/11/99

HEALTH DEPT. COPY: WHITE INSPECTION COPY (FINAL): GREEN OWNER COPY (FINAL): YELLOW INSPECTION COPY (INITIAL): PINK OWNER COPY (INITIAL): GOLD