IREDELL COUNTY HEALTH DEPARTMENT

STATESVILLE 704-878-5305 MOORESVILLE 704-664-5281

IMPROVEMENT PERMIT / AUTHORIZATION TO CONSTRUCT / OPERATION PERMIT / EXISTING SYSTEM INSPECTION

PERMIT# 073127 PIN# 4626960666 DATE 5/21/98

OWNER OR CONTRACTOR RON HOLDER PHONE: Business 419-884-2334 Home

ADDRESS 2773 BELL RD. - MANSFIELD - OH 44904

LOCATION BRANLEY SCHOOL - TR POPLAR GROVE - TR TAWNY BARK - TL TALL OAK ON RT

SUBDIVISION POPLAR GROVE BLOCK / SECTION — LOT 22 LOT AREA — SITE CLASS. PS DESIGN FLOW 360 GPD L.T.A.R. .30 GPD/FT²

Septic Tank: 1000 Gallons; STB 794 Date 2/19/99
Pump Tank: 1000 Gallons; PT Date
Pump Make: HYDRO Model SHEFSOA Serial No. 3-99
Nitrification Field: No Fields 1 Square Feet 900 Linear Feet 300
No Lines 4@75' Trench Width 36" Max Trench Bottom Depth 36" Gravel Depth N/A

☑ New System ☐ Repair System Type: I, II, III, IV, V, VI
System Description: PUMP CHAMBERS OR HDS
Repair System Description: PUMP PANEL
Maintenance Agreement Required: ☐ Yes ☑ No


☑ House/Mod. Home No. Bedrooms 3
☐ Mobile Home No. Bathrooms 2
☐ Business No. Employees
☐ Other
☐ Slab ☐ Crawl Space ☑ Basement w/plumbing ☐ Basement wo/plumbing

Water Supply: ☑ Individual ☐ Public ☐ Community


Comments:/Conditions: KEEP TANKS 50' FROM NEIGHBOR'S WELL. ✱

Comments:/Conditions: Panel Repair in rear of house.

INITIAL SITE SKETCH 1"=40'

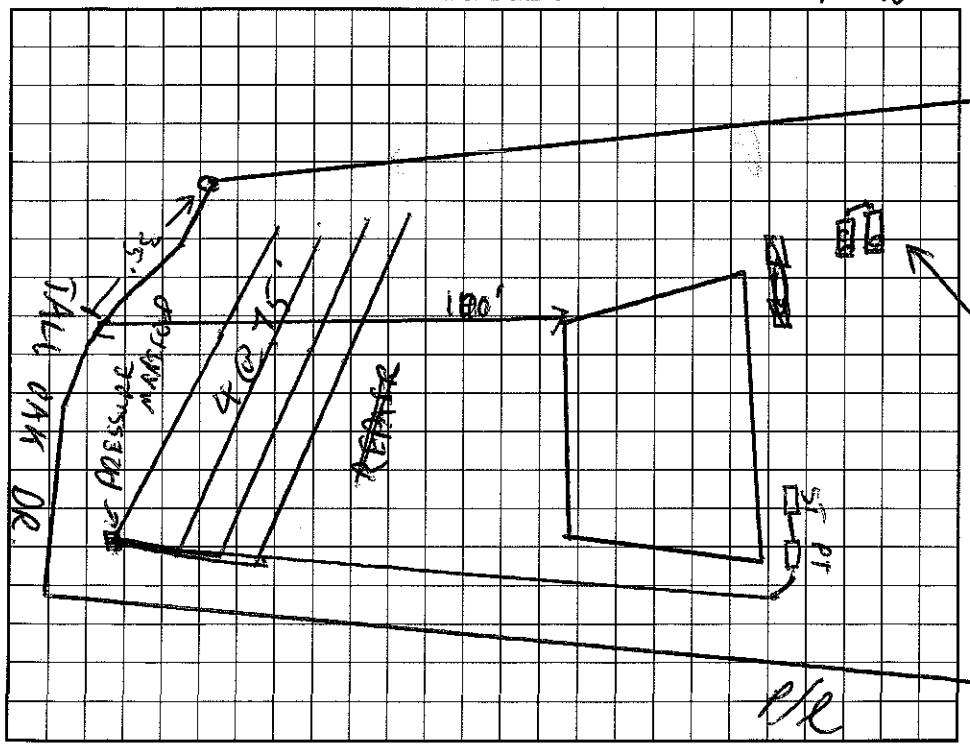

AS BUILT SKETCH

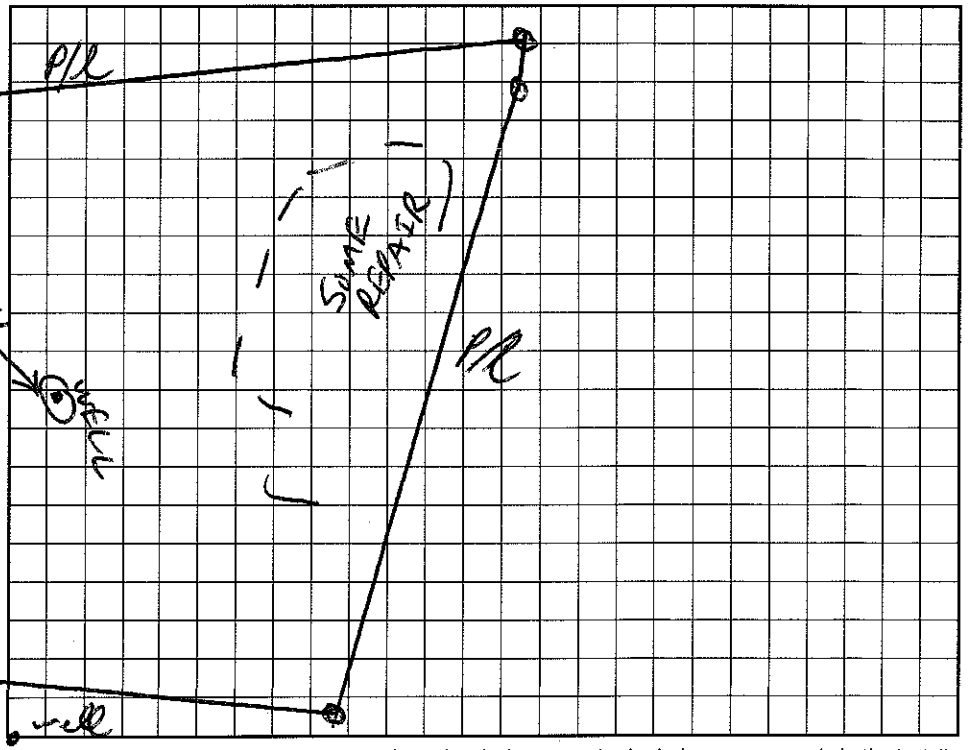

I understand that this permit can be suspended or revoked if any false information is supplied toward securing the permit/any unauthorized changes are made to the site/any unauthorized changes are made in the installation of the system. Improvement Permit with plat valid without expiration. Improvement Permit with site plan valid for sixty months. Authorization to Construct is valid for a period equal to that of Improvement Permit – not to exceed sixty months.

Signed: Robert J. Wessmiller for Ron Holder date 5/27/98 Installed by: Maxhead

Improvement Permit by: C. [signature] RS date 5/21/98 Operation Permit by: Jeff Morgan date 6/10/99

Authorization to Construct by: C. [signature] RS date 5/21/98 Existing System Inspection by: Jeff Morgan date 6/10/99

HEALTH DEPT. COPY: WHITE INSPECTION COPY (FINAL): GREEN OWNER COPY (FINAL): YELLOW INSPECTION COPY (INITIAL): PINK OWNER COPY (INITIAL): GOLD