IREDELL COUNTY HEALTH DEPARTMENT

Expansion ones Ø

STATESVILLE 704-878-5305 MOORESVILLE 704-664-5281

IMPROVEMENT PERMIT / AUTHORIZATION TO CONSTRUCT / OPERATION PERMIT / EXISTING SYSTEM INSPECTION

PERMIT # 155366 PIN # 4626961476.000 DATE 3/12/09

OWNER or APPLICANT Eric Rosentreter PHONE: Business 704 664 3491 Home: 704 664-3911

OWNER or APPLICANT ADDRESS 112 Tall Oak Dr. Mooresville NC 28117

LOCATION / DIRECTIONS Brawley Sch. Rd. TR Poplar Grove TR Tawny Bark TL Tall Oak on(R)

SUBDIVISION Poplar Grove BLOCK / SECTION LOT # 24 LOT AREA ≈ 25,000 DESIGN FLOW 480gpd L.T.A.R. 3

Septic Tank 1000 Gallons: STB 794 Date 8-18-08

Pump Tank Gallons: P T Date

Pump Make Model Serial #

Nitrification Field No Fields No Lines 2 Linear Feet 24'

Trench Width 36" Max. Trench Bottom Depth 36" Gravel Depth 12"

☐ New System ☐ Repair ☑ Expansion System Type I II III IV V VI

System Description: Gravity Convetional or Accepted

Repair System Description: Gravity PPBPS System

Maintenance Agreement Required ☐ YES ☑ NO

☐ GRAVITY ☐ PRESSURE


☑ Residence No. Bedrooms 4 ☐ Business No. Persons ☐ Other No. Employees ☐ Slab ☐ Crawl Space ☑ Basement w/plumbing ☐ Basement w/o plumbing

Water Supply: ☑ Private ☐ Public ☐ Community


Comments / Conditions: Abandon Exis ST, Install New 1000gallon S/T min 15' from pond/Pool. Cut off (Excavate) 12' from lines 1 and 2. Install new header ditch with 6 drop boxes. for serial Distribution.

Comments / Conditions: Install (2) 12' conventional lines on line 5 + 6 or (1) 20' Accepted system on line 5.

INITIAL SITE SKETCH

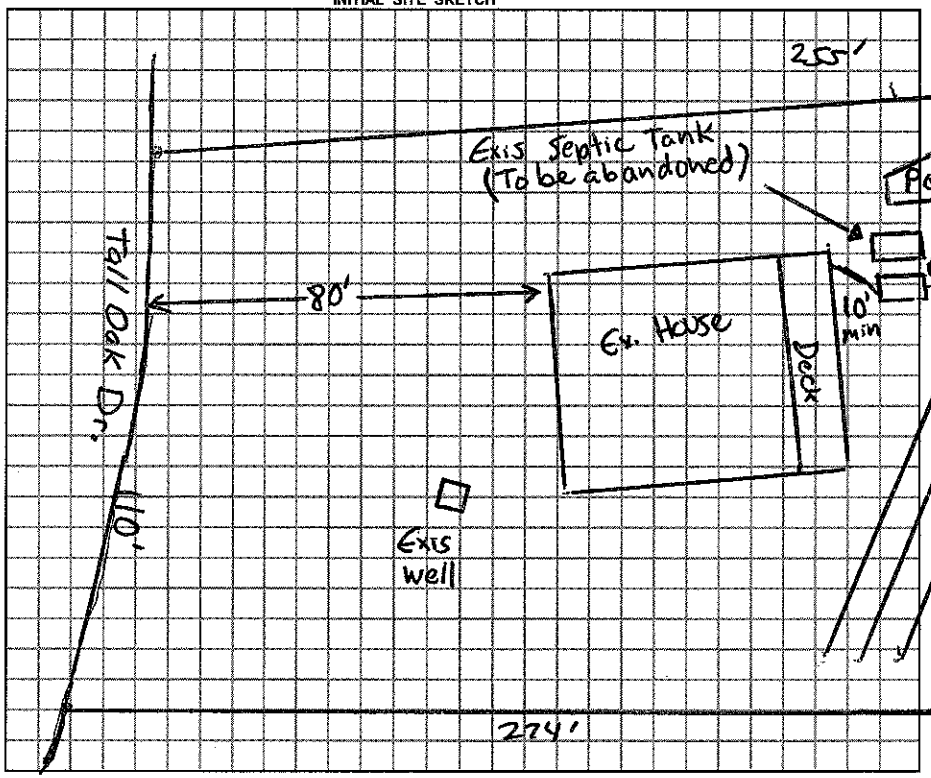

AS BUILT SKETCH

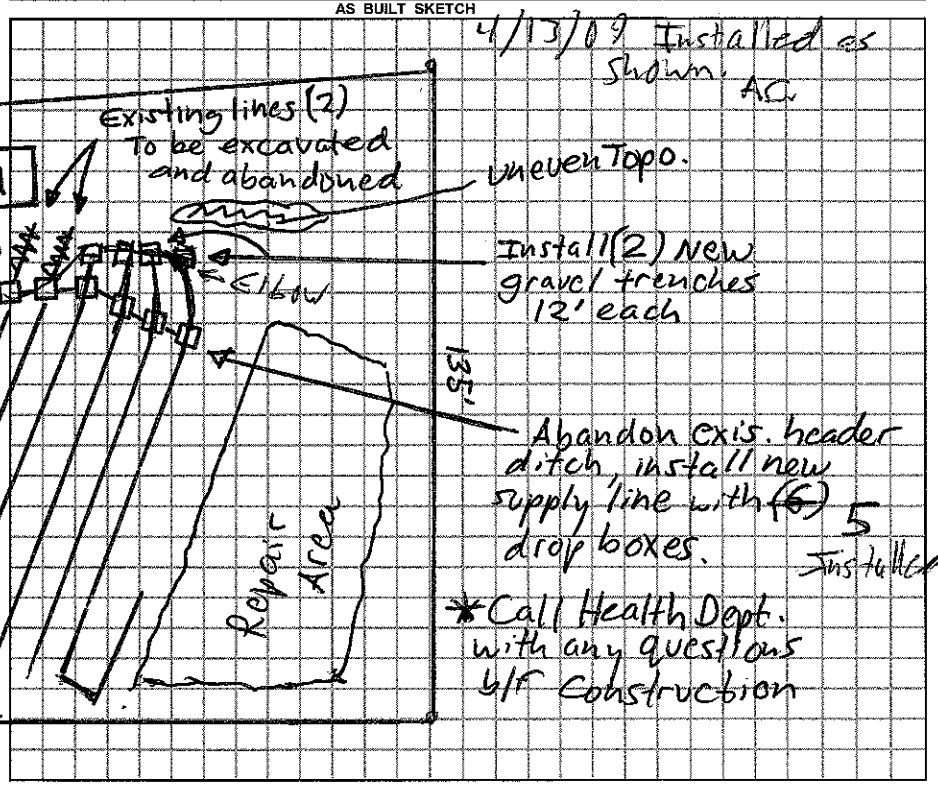

Permit can be suspended or revoked if any false information is supplied toward securing the permit / any unauthorized changes are made to the site / any unauthorized changes are made in the installation of the system.

☐ *IMPROVEMENT PERMIT w / plat valid without expiration.* ☐ *IMPROVEMENT PERMIT w / site plan valid for 60 mos.* ☑ *AUTHORIZATION TO CONSTRUCT valid for period equal to IMPROVEMENT PERMIT-not to exceed 60 mo.*

Owner / Applicant Signature: Eric Rosentreter Date 3/12/09

Improvement Permit by: Anthony Coker Jr. R.S. Date 3/12/09

Authorzation to Construct by: Anthony Coker Jr. R.S. Date 3/12/09

YOU SHOULD CONTACT A LOCATOR SERVICE PRIOR TO ANY EXCAVATION.

Installed by: Owner - Installed

Operation Permit by: Anthony Coker Jr R.S. Date: 4/13/09

Existing System Inspected by: Date:

WHITE COPY Environmental Health YELLOW COPY (Final) Owner / Applicant PINK COPY (Initial) Owner / Applicant