IREDELL COUNTY HEALTH DEPARTMENT

STATESVILLE 704-878-5305 MOORESVILLE 704-664-5281

IMPROVEMENT PERMIT / CERTIFICATE OF COMPLETION / OPERATION PERMIT / EXISTING SYSTEM INSPECTION

PROPERTY DESCRIPTION NO. 174877 DATE March 24, 1994 TAX MAP NO. 2F11A24 Watershed: ☐ Yes ☐ No

OWNER OR CONTRACTOR Erica Rosenthaler PHONE: Business _____ Home 664-3911 LIV

ADDRESS Rt 9 Box 866A Mooresville

LOCATION 1180 TR Poplar Grove TR Tammy Beck TL Tall Oak Dr. on Right

SUBDIVISION Poplar Grove BLOCK / SECTION _____ LOT 24 LOT AREA 25,000 ft² SITE CLASS. B5pn.1 DESIGN FLOW 480 gpd L.T.A.R. 0.3

Septic Tank: 1000 Gallons; STB 794 Date 9/16/94

Pump Tank: _____ Gallons; PT _____ Date _____

Pump Make: _____ Model _____ Serial No. _____

Nitrification Field: No Fields 2 Square Feet 1620 Linear Feet 540

No Lines 3+3 Trench Width 36" Max Trench Bottom Depth 36" Gravel Depth 12"

☑ New System ☐ Repair System Type: I, II, III, IV, V, VI

System Description: gravity conventional

Repair System Description: gravity RIBS

Maintenance Agreement Required: ☐ Yes ☑ No

☑ House/Mod. Home No. Bedrooms 4/4

☐ Mobile Home No. Bathrooms 4

☐ Business No. Employees _____

☑ Other _____


☐ Slab ☐ Crawl Space ☑ Basement w/plumbing ☐ Basement wo/plumbing

Water Supply: ☑ Individual ☐ Community ☐ Public

Comments: Install all trenches at 36" from bottom Right & Rear of lot reinstated by backhoe pump

Comments: Installed as drawn on Imp. Permit

INITIAL SITE SKETCH

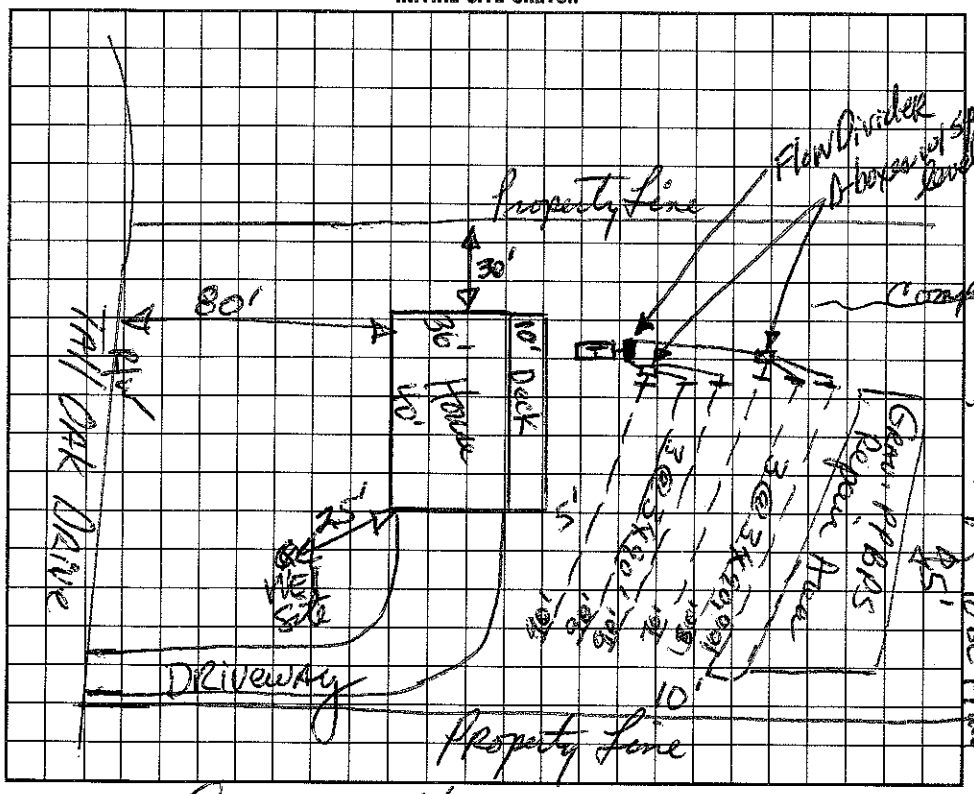

AS BUILT SKETCH

I understand that this permit can be suspended or revoked if any false information is supplied toward securing the permit/any unauthorized changes are made to the site/any unauthorized changes are made in the installation of the system. Improvement Permit is valid for 60 months from date of issuance.

Signed: _____

Improvement Permit by: Jarrell Hinson IRS date 3/24/94

Existing System Inspection by: _____ date _____

Installed by: Richard Abernathy

Certificate of Completion by: Wesley Sparks RS. date 11/2/94

Operation Permit by: _____ date _____

HEALTH DEPT. COPY: WHITE INSPECTION COPY (FINAL): GREEN OWNER COPY (FINAL): YELLOW INSPECTION COPY (INITIAL): PINK OWNER COPY (INITIAL): GOLD