IREDELL COUNTY HEALTH DEPARTMENT

STATESVILLE 704-878-5305 MOORESVILLE 704-664-5281

IMPROVEMENT PERMIT / CERTIFICATE OF COMPLETION / OPERATION PERMIT / EXISTING SYSTEM INSPECTION

PROPERTY DESCRIPTION NO. 66304 DATE Oct 20, 93 TAX MAP NO. 2F11A26 Watershed: ☑ Yes ☐ No

OWNER OR CONTRACTOR Kyle Howell PHONE: Business _____ Home 4626-96-2283 LM

ADDRESS 6201 Cotton Rd., Huntersville NC 28078

LOCATION 11th Rt into Poplar Grove Rear Rt on Tawny Brook Corner lot w/ Tall Oak Dr.

SUBDIVISION Poplar Grove BLOCK / SECTION _____ LOT 26 LOT AREA ~28,000ft SITE CLASS PS DESIGN FLOW 360gpd L.T.A.R. .4

Septic Tank: 1000 Gallons; STB 714 Delling Date Aug 9, 93

Pump Tank: _____ Gallons; PT _____ Date _____

Pump Make: _____ Model _____ Serial No. _____

Nitrification Field: No Fields 1 Square Feet 900 Linear Feet 300

No Lines 3 Trench Width 36" Max Trench Bottom Depth 36" Gravel Depth 12"

☑ New System ☐ Repair System Type: I, II, III, IV, V, VI

System Description: gravity conventional

Repair System Description: Sanifor LPS/CONV.

Maintenance Agreement Required: ☐ Yes ☑ No

☑ House/Mod. Home No. Bedrooms 3

☐ Mobile Home No. Bathrooms 2

☐ Business No. Employees _____

☐ Other _____

☐ Slab ☑ Crawl Space ☐ Basement w/plumbing ☐ Basement wo/plumbing


Water Supply: ☑ Individual ☐ Community ☐ Public

Comments:

Comments:
Pad installed in lower trench due to excessive ditch bottom grade

INITIAL SITE SKETCH

AS BUILT SKETCH

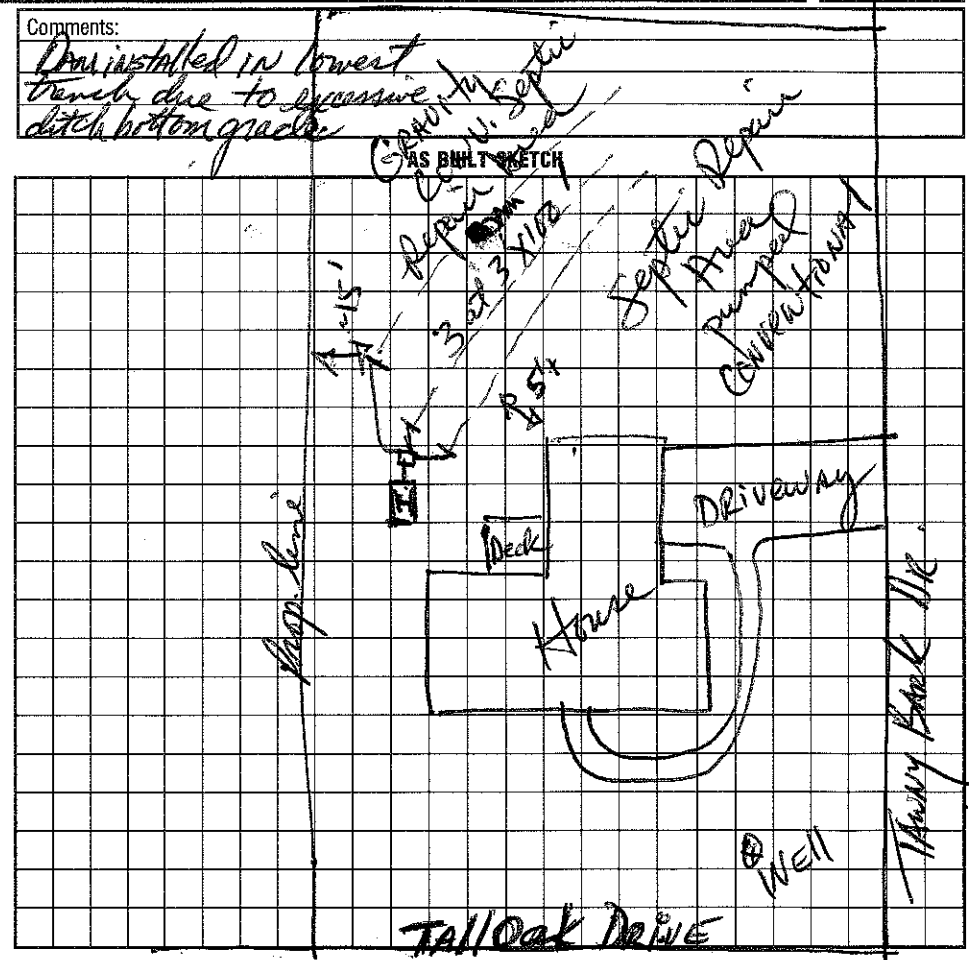

I understand that this permit can be suspended or revoked if any false information is supplied toward securing the permit/any unauthorized changes are made to the site/any unauthorized changes are made in the installation of the system. Improvement Permit is valid for 60 months from date of issuance.

Signed: _____

Improvement Permit by: _____ date _____

Existing System Inspection by: _____ date _____

Installed by: Thomas Cope

Certificate of Completion by: [illegible] date 10/20/93

Operation Permit by: _____ date _____

HEALTH DEPT. COPY: WHITE INSPECTION COPY (FINAL): GREEN OWNER COPY (FINAL): YELLOW INSPECTION COPY (INITIAL): PINK OWNER COPY (INITIAL): GOLD