IREDELL COUNTY HEALTH DEPARTMENT

AUTHORIZATION TO CONSTRUCT

STATESVILLE 704-878-5305 MOORESVILLE 704-664-5281

IMPROVEMENT PERMIT / ~~CERTIFICATE OF COMPLETION~~ / OPERATION PERMIT / EXISTING SYSTEM INSPECTION

PROPERTY DESCRIPTION NO. 23422 DATE 12/13/96 TAX MAP NO. 2F-11-A-25 Watershed: ☑ Yes ☐

OWNER OR CONTRACTOR TONY KRALOVIC PHONE: Business Home 663 3655

ADDRESS 202 DEER CIRCLE MOORESVILLE 46216-96-2315

LOCATION BRAWLEY SCHOOL RD - TR POPLAR GROVE - TR TAWNY BARK - TL TALL OAK DR - ON RT

SUBDIVISION POPLAR GROVE BLOCK / SECTION LOT 25 LOT AREA SITE CLASS. PS DESIGN FLOW 360GPD L.T.A.R. .36 APPLIED

Septic Tank: 1000 Gallons; STB 794 Date 9/23/97

Pump Tank: Gallons; PT Date

Pump Make: Model Serial No.

Nitrification Field: No Fields 1 Square Feet 1200 Linear Feet 400

No Lines 5 Trench Width 36" Max Trench Bottom Depth 24" Gravel Depth ~~6~~ 12"

☑ New System ☐ Repair System Type: I, II, III, IV, V, VI

System Description: GRAVITY CONVENTIONAL

Repair System Description: CHANGED OR SIMILAR

Maintenance Agreement Required: ☐ Yes ☑ No

☑ House/Mod. Home No. Bedrooms 3

☐ Mobile Home No. Bathrooms 2

☐ Business No. Employees

☐ Other


☐ Slab ☑ Crawl Space ☐ Basement w/plumbing ☐ Basement wo/plumbing

Water Supply: ☑ Individual ☐ Community ☐ Public


Comments:

Comments:

INITIAL SITE SKETCH 1" = 50'

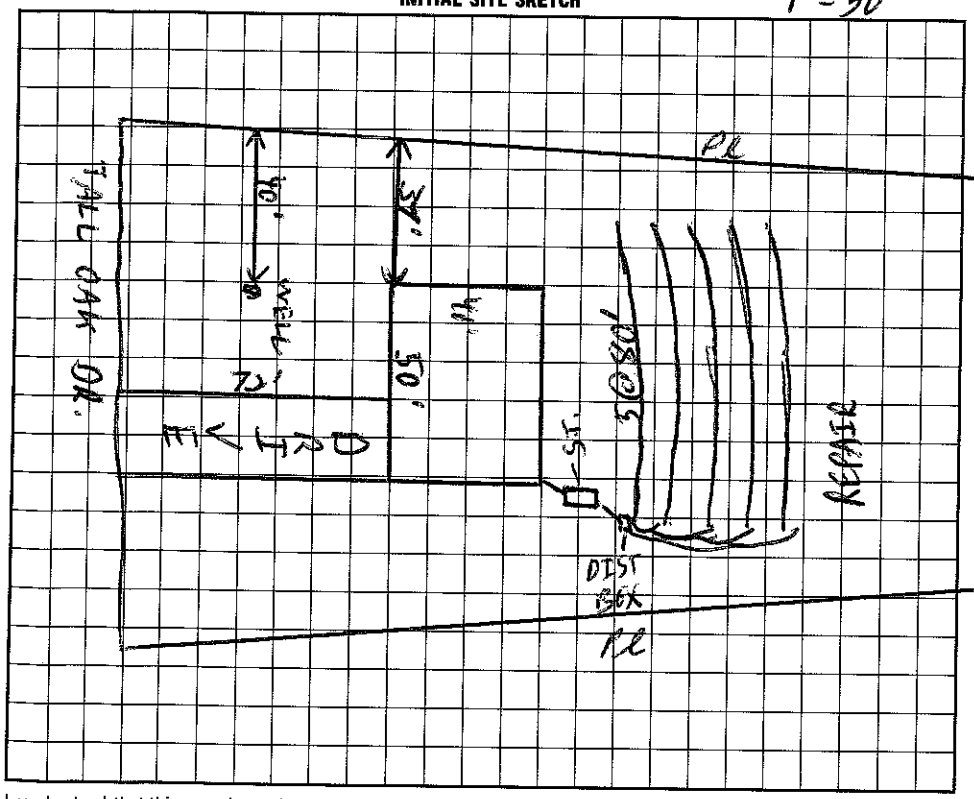

AS BUILT SKETCH

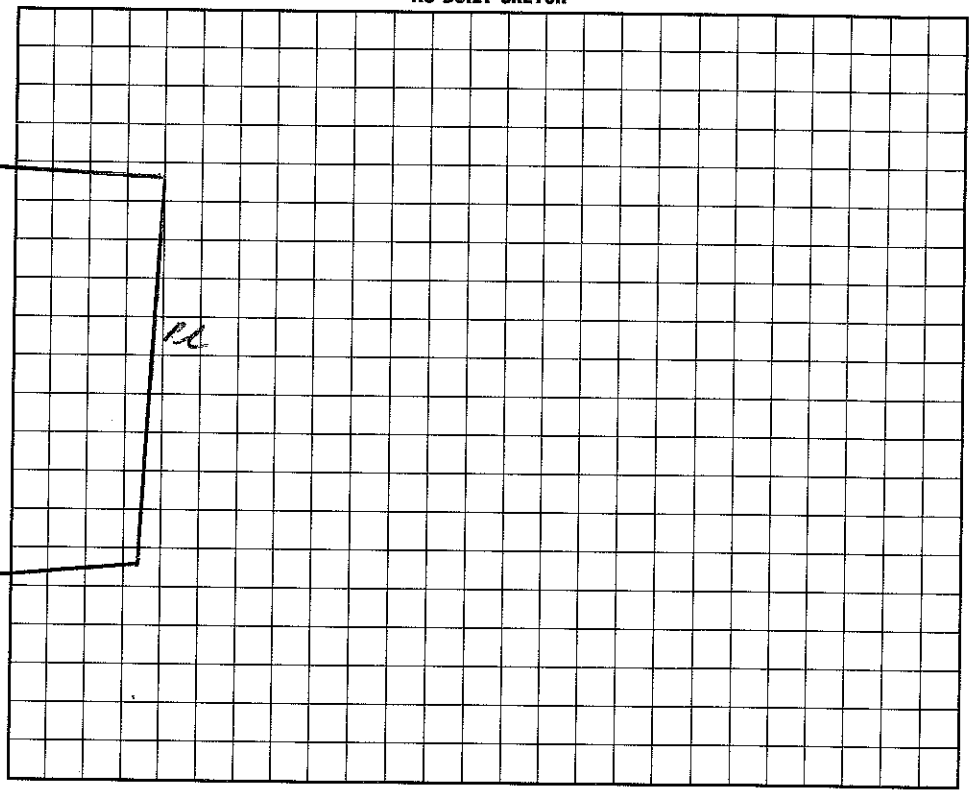

I understand that this permit can be suspended or revoked if any false information is supplied toward securing the permit/any unauthorized changes are made to the site/any unauthorized changes are made in the installation of the system.

Signed: 12-16-96

~~Improvement~~ Permit by: EHS date 12/13/96

~~As-Built~~ Existing System ~~Inspection~~ by: EHS date 12/13/96

Installed by: LARRY BEAM

Certificate of Completion by: date

Operation Permit by: date 11/6/97

HEALTH DEPT. COPY: WHITE INSPECTION COPY (FINAL): GREEN OWNER COPY (FINAL): YELLOW INSPECTION COPY (INITIAL): PINK OWNER COPY (INITIAL): GOLD