IREDELL COUNTY HEALTH DEPARTMENT

STATESVILLE 704-878-5305 MOORESVILLE 704-664-5281

IMPROVEMENT PERMIT / CERTIFICATE OF COMPLETION / OPERATION PERMIT / EXISTING SYSTEM INSPECTION

PROPERTY DESCRIPTION NO. 20343 DATE 3/3/95 TAX MAP NO. 2F-11-A-44 Watershed: ☐ Yes ☐ No

OWNER OR CONTRACTOR Keith Lewis PHONE: Business Home 662-9816

ADDRESS 208 Dish Circle Mooresville, NC 28115 46226-96-3072

LOCATION 100' TR Poplar Grove Rd TR on Tawny Bark Rd.

SUBDIVISION Poplar Grove BLOCK / SECTION LOT 44 LOT AREA .65 Ac. SITE CLASS P DESIGN FLOW 480 L.T.A.R. .25-.3

Septic Tank: 1000 Gallons; STB T/H Kellogg Date 5-31-95

Pump Tank: Gallons; PT 0 Date

Pump Make: Model Serial No.

Nitrification Field: No Fields 1 Square Feet 1599 Linear Feet 533

No Lines 5 Trench Width 36" Max Trench Bottom Depth 36" Gravel Depth 12"

☑ New System ☐ Repair System Type: I, II, III, IV, V, VI

System Description: 01ST BOX - CONVENTIONAL

Repair System Description: GRAVITY PANEL

Maintenance Agreement Required: ☐ Yes ☐ No

☑ House/Mod. Home ☐ Mobile Home ☐ Business ☐ Other

No. Bedrooms 4 No. Bathrooms 2.5 No. Employees


☐ Slab ☑ Crawl Space ☐ Basement w/plumbing ☐ Basement wo/plumbing

Water Supply: ☑ Individual ☐ Community ☐ Public


Comments:

Comments: 8-3-95 Parking w/well on front yard - Sanitized to main Dist. ST to be set when blown w/ INF Laterals 12 @ 150' from high with and contour last. JM

INITIAL SITE SKETCH

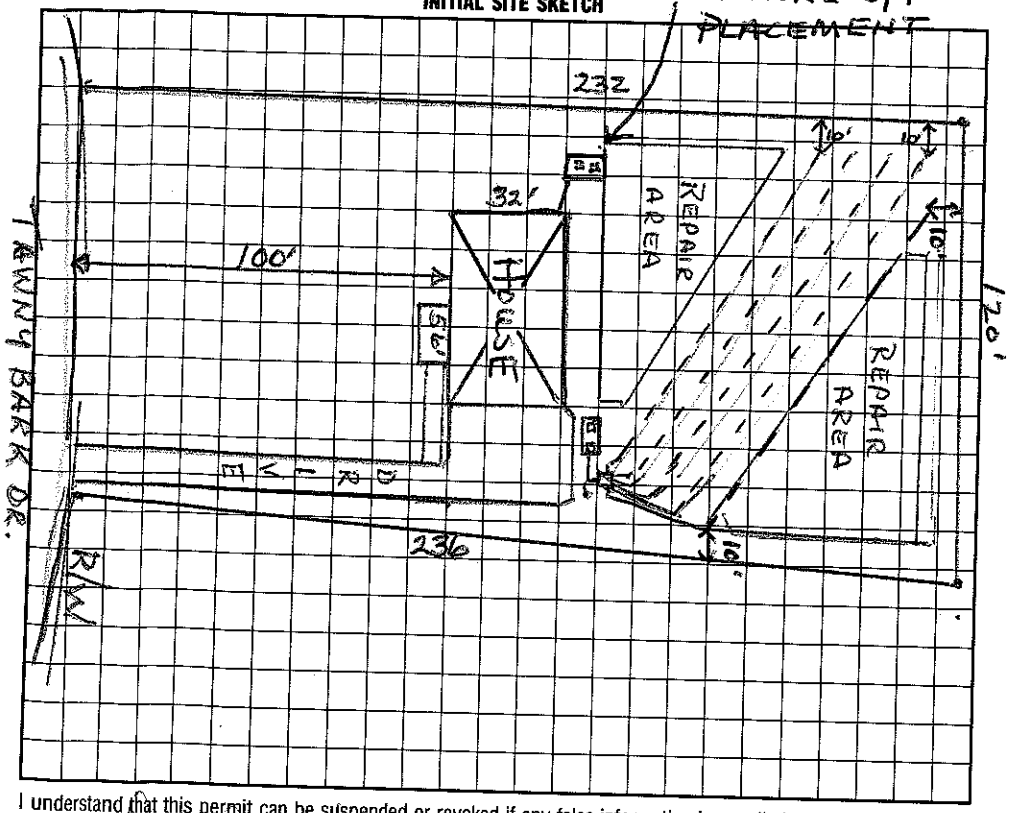

AS BUILT SKETCH

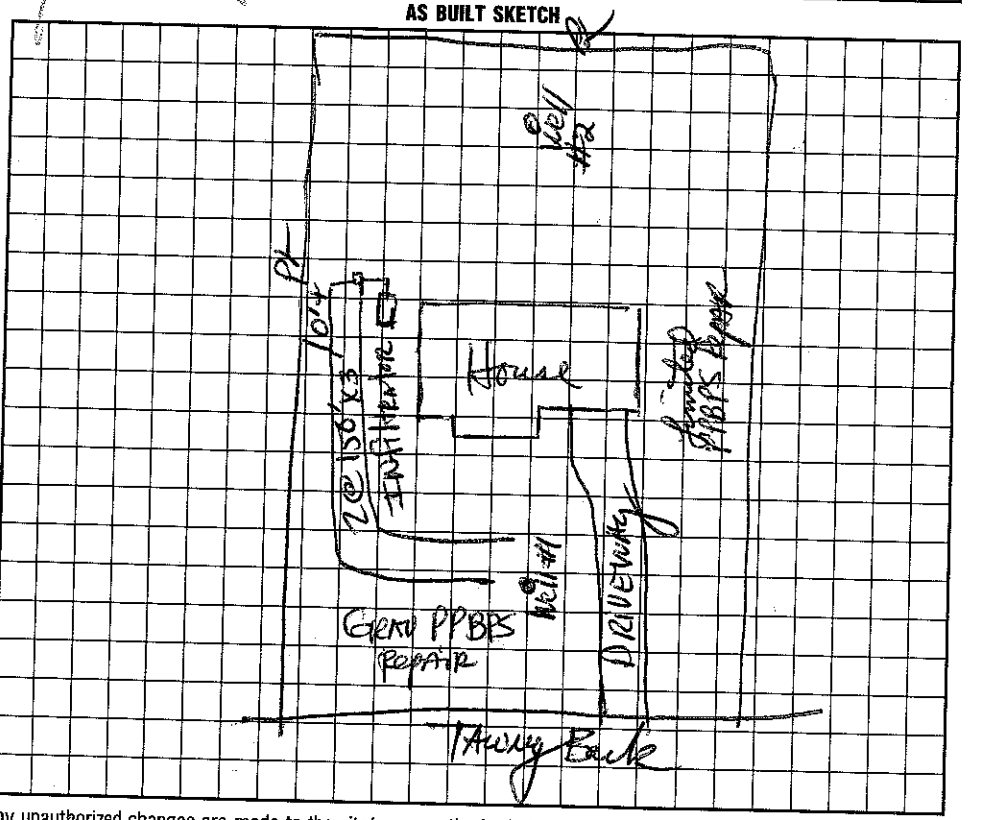

I understand that this permit can be suspended or revoked if any false information is supplied toward securing the permit/any unauthorized changes are made to the site/any unauthorized changes are made in the installation of the system. Improvement Permit is valid for 60 months from date of issuance.

Signed:

Improvement Permit by: Wesley Sparks R.S. date 3/3/95

Existing System Inspection by: date

Installed by: Richard Abernathy

Certificate of Completion by: Wesley Sparks R.S. date 8/14/95

Operation Permit by: date

HEALTH DEPT. COPY: WHITE INSPECTION COPY (FINAL): GREEN OWNER COPY (FINAL): YELLOW INSPECTION COPY (INITIAL): PINK OWNER COPY (INITIAL): GOLD