IREDELL COUNTY HEALTH DEPARTMENT

STATESVILLE 704-878-5305 MOORESVILLE 704-664-5281

IMPROVEMENT PERMIT / CERTIFICATE OF COMPLETION / OPERATION PERMIT / EXISTING SYSTEM INSPECTIO

PROPERTY DESCRIPTION NO. 20188 DATE April 24 '95 TAX MAP NO. 2F11 A43 Watershed: ☑ Yes ☐ No

OWNER OR CONTRACTOR James Modzelewski PHONE: Business 875-8629 Home

ADDRESS 14705 Glendale Rd Huntersville 28078 WSII CA 416216-960-4078

LOCATION Brawley School Rd TR Poplar Grove TR Tawny Brook Dr.

SUBDIVISION Poplargrove BLOCK / SECTION LOT 43 LOT AREA 1.0Ac SITE CLASS. B per B3 DESIGN FLOW 450 gpd L.T.A.R. .03

Septic Tank: 1000 Gallons; STB 704 Date 10/5/95

Pump Tank: Gallons; PT Date

Pump Make: Model Serial No.

Nitrification Field; No Fields 1 Square Feet 1200 Linear Feet 400

No Lines 4 Trench Width 36" Max Trench Bottom Depth 36" Gravel Depth NA

☑ New System ☐ Repair System Type: I, II, III, IV, V, VI

System Description: Glass IV INFILTRATOR

Repair System Description: same as LPPPBPS

Maintenance Agreement Required: ☐ Yes ☑ No

☑ House/Mod. Home No. Bedrooms 4

☐ Mobile Home No. Bathrooms 2½

☐ Business No. Employees

☐ Other

☐ Slab ☐ Crawl Space ☐ Basement w/plumbing ☐ Basement wo/plumbing


Water Supply: ☑ Individual ☐ Community ☐ Public

Comments: 4/25/95 ok to move house to 15' off right side and go front entry garage as proposed now by Mr Modzelewski.

Comments: drawn as shown on shop Permit

1" = 50'

INITIAL SITE SKETCH

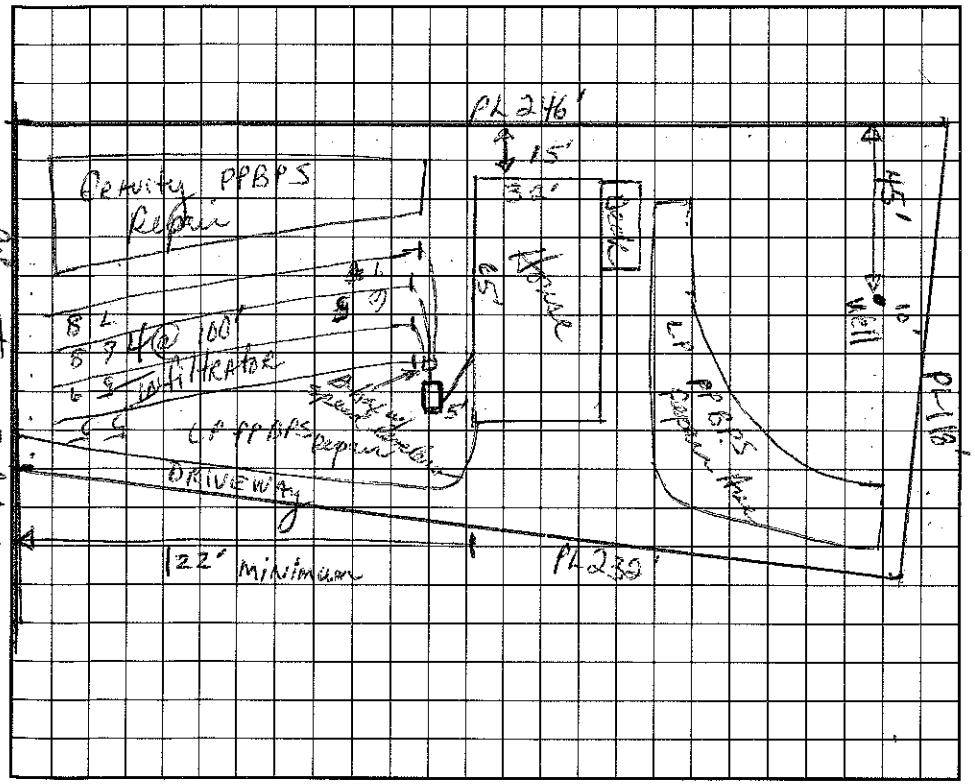

AS BUILT SKETCH

I understand that this permit can be suspended or revoked if any false information is supplied toward securing the permit/any unauthorized changes are made to the site/any unauthorized changes are made in the installation of the system. Improvement Permit is valid for 60 months from date of issuance.

Signed:

Improvement Permit by: date 4/24/95

Existing System Inspection by: date

Installed by: Richard Abernathy

Certificate of Completion by: date

Operation Permit by: Wesley Sparks RS date 12/22/95

HEALTH DEPT. COPY: WHITE INSPECTION COPY (FINAL): GREEN OWNER COPY (FINAL): YELLOW INSPECTION COPY (INITIAL): PINK OWNER COPY (INITIAL): GOLD