IREDELL COUNTY HEALTH DEPARTMENT

STATESVILLE 704-878-5305 ~~MOORESVILLE~~ 704-664-5281

IMPROVEMENT PERMIT / AUTHORIZATION TO CONSTRUCT / OPERATION PERMIT / EXISTING SYSTEM INSPECTION

PERMIT # 104347 PIN # 4626-96-5154 DATE 12-4-12

OWNER or APPLICANT GRANDE HOMES PHONE: Business 704-400-1710 Home:

OWNER or APPLICANT ADDRESS 555 DELBERG ST. DAVIDSON

LOCATION / DIRECTIONS RSR, TR POPLAR GROVE, TR TAWNY BARK, ON R

SUBDIVISION POPLAR GROVE BLOCK / SECTION LOT # 42 LOT AREA .638 AC DESIGN FLOW 480 L.T.A.R. .35 (.3R)

Septic Tank 1000 Gallons: STB 794 Date 11-6-12
Pump Tank Gallons: P T Date
Pump Make Model Serial #
Nitrification Field No Fields 1 No Lines 5 Linear Feet 342'
Trench Width 36" Max. Trench Bottom Depth 36" Gravel Depth —

☒ New System ☐ Repair ☐ Expansion System Type I II (III) IV V VI
System Description: 25% REDUCTION
Repair System Description: LP - PANEL BLOCK
Maintenance Agreement Required ☐ YES ☒ NO
☒ GRAVITY ☐ PRESSURE


☒ Residence No. Bedrooms 4
☐ Business No. Persons
☐ Other No. Employees
☐ Slab ☒ Crawl Space
☐ Basement w/plumbing ☐ Basement w/o plumbing

Water Supply: ☒ Private ☐ Public ☐ Community


Comments / Conditions STAY 15' FROM ANY 2' CUT

Comments / Conditions

INITIAL SITE SKETCH

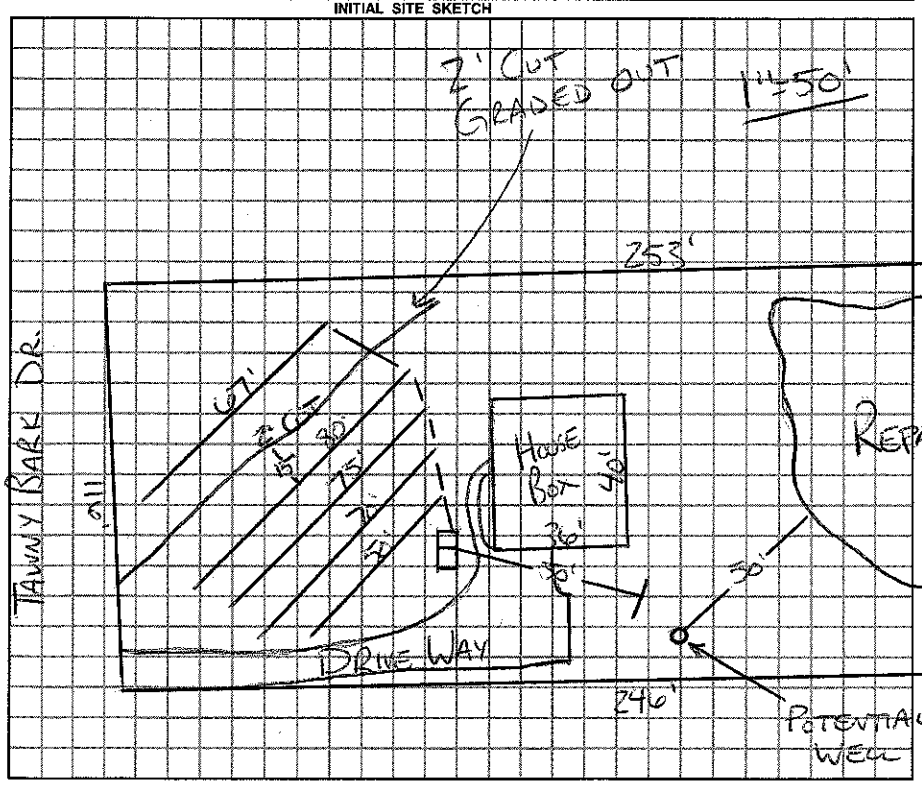

AS BUILT SKETCH

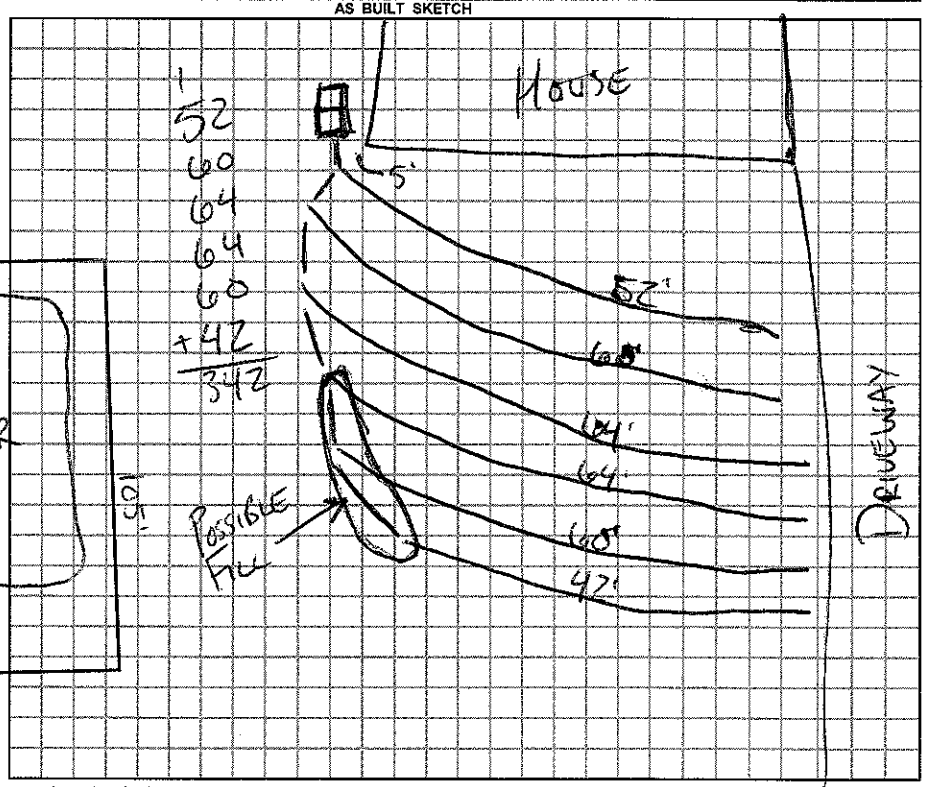

Permit can be suspended or revoked if any false information is supplied toward securing the permit / any unauthorized changes are made to the site / any unauthorized changes are made in the installation of the system.

☐ *IMPROVEMENT PERMIT w / plat valid without expiration.* ☒ *IMPROVEMENT PERMIT w / site plan valid for 60 mos.* ☒ *AUTHORIZATION TO CONSTRUCT valid for period equal to IMPROVEMENT PERMIT-not to exceed 60 mo.*

Owner / Applicant Signature: Date 12-5-12

Improvement Permit by: Date 12-4-12

Authorization to Construct by: Date 12-4-12

YOU SHOULD CONTACT A LOCATOR SERVICE PRIOR TO ANY EXCAVATION.

Installed by: LAWING GRADING

Operation Permit by: Date: 3-4-13

Existing System Inspected by: Date:

WHITE COPY Environmental Health YELLOW COPY (Final) Owner / Applicant PINK COPY (Initial) Owner / Applicant