IREDELL COUNTY HEALTH DEPARTMENT

Authorization to Construct

STATESVILLE 704-878-5305 MOORESVILLE 704-664-5281

4.00 6.30

IMPROVEMENT PERMIT / ~~CERTIFICATE OF COMPLETION~~ / OPERATION PERMIT / EXISTING SYSTEM INSPECTION

PROPERTY DESCRIPTION NO. 24304 DATE 5/30/97 TAX MAP NO. 2F-11-4-2a Watershed: ☒ ~~Yes~~ ☐ No

OWNER OR CONTRACTOR KEVIN COMBS / JOHN H. DUPONT, JR PHONE: Business 4626 96 5679 Home 391-0966

ADDRESS CHARLOTTE NC

LOCATION BRAWLEY SCHOOL RD - TR POPLAR GROVE - TR TAWNY BARK - TL SYCAMORE - 3RD ON LT

SUBDIVISION POPLAR GROVE BLOCK / SECTION _____ LOT 29 LOT AREA _____ SITE CLASS. PS DESIGN FLOW 360 GPD L.T.A.R. .36 M/FT²

Septic Tank: 1000 Gallons; STB 325 Date 5/20/97

Pump Tank: 1000 Gallons; PT 47 Date 6/27/97

Pump Make: _____ Model _____ Serial No. _____

Nitrification Field: No Fields 1 Square Feet 900 Linear Feet 300

No Lines ~~3 @ 100'~~ Trench Width 36" Max Trench Bottom Depth 36" Gravel Depth N/A

☒ New System ☐ Repair System Type: I, II, (III), IV, V, VI

System Description: PUMP CHAMBERED OR SIMILAR

Repair System Description: PUMP PANEL

Maintenance Agreement Required: ☐ Yes ☒ No

☒ House/Mod. Home No. Bedrooms 3

☐ Mobile Home No. Bathrooms 2

☐ Business No. Employees _____

☐ Other _____


☐ Slab ☑ Crawl Space ☐ Basement w/plumbing ☐ Basement wo/plumbing

Water Supply: ☒ Individual ☐ Community ☐ Public


Comments: 4 @ 75'

Comments:

INITIAL SITE SKETCH 1"=50'

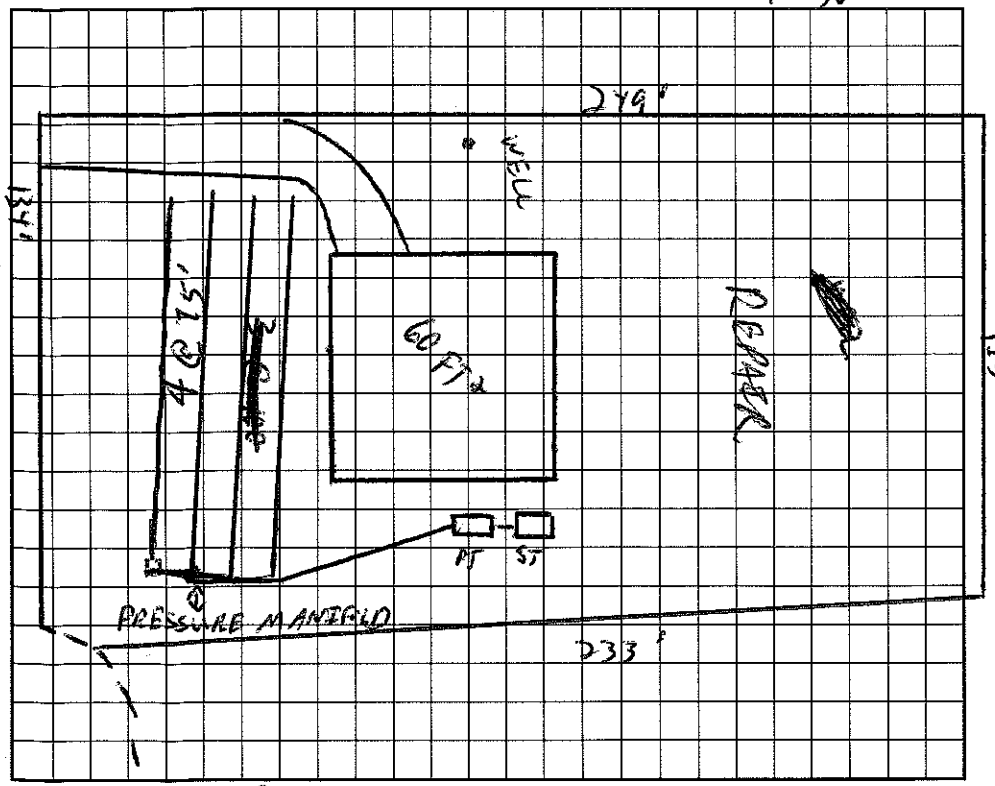

AS BUILT SKETCH

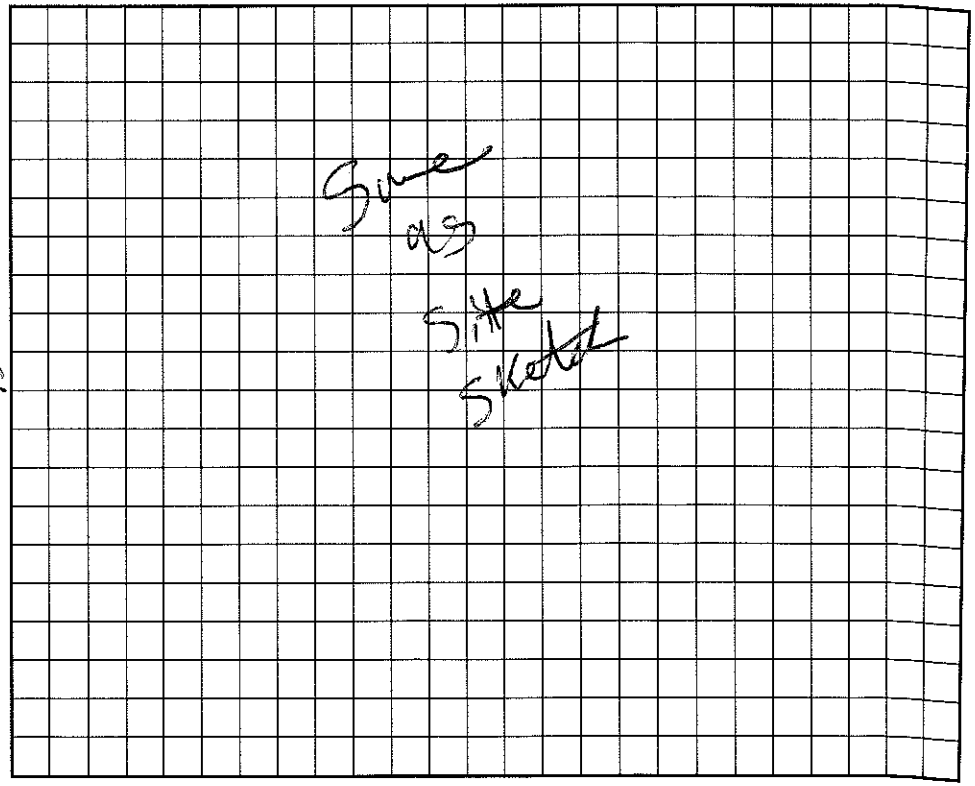

I understand that this permit can be suspended or revoked if any false information is supplied toward securing the permit/any unauthorized changes are made to the site/any unauthorized changes are made in the installation of the system. Improvement Permit is valid for 60 months from date of issuance.

Signed: John H. Dupont, Jr.

Improvement Permit by: C. Ray Freeman date 5/30/97

Existing System Inspection by: AUTHORIZATION C. Ray Freeman date 5/30/97

CONSTRUCT

Installed by: WAYNE Klontz

Certificate of Completion by: _____ date _____

Operation Permit by: C. Ray Freeman date 8/15/97

HEALTH DEPT. COPY: WHITE INSPECTION COPY (FINAL): GREEN OWNER COPY (FINAL): YELLOW INSPECTION COPY (INITIAL): PINK OWNER COPY (INITIAL): GOLD