ICHD - ENVIRONMENTAL HEALTH DIVISION

Statesville Office (704) 878-5305 | Mooresville Office (704) 660-3625 | PERMIT # 308735

SEPTIC: IMPROVEMENT PERMIT / AUTHORIZATION TO CONSTRUCT / OPERATION PERMIT / EXISTING SYSTEM

PIN # 4626966179 ✓

APPLICANT/OWNER: Jeff Epstein | APPLICANT ADDRESS: 220 Tawny Bark Dr Mooresville NC

SITE ADDRESS: 220 Tawny Bark Dr Mooresville NC 28117 ✓ | PHONE: 704-576-6807 | ALT. PHONE -

SITE DIRECTIONS: Brawley school Road Ron Poplar grove R on Tawny Bark | SAP CONTROLLED: ☐ YES ☐ NO

SUBDIVISION: Poplar Grove ✓ | SECTION: - | LOT # 41 ✓ | LOT AREA: 0.65 Acre | DESIGN FLOW: Exist'g | L.T.A.R.: Exist'g

Septic Tank 1000 (gal) | STB 794 | Date 4-12-2020
Pump Tank (gal) | PT | Date
Pump Make | Model | Serial #
Nitrification Fields | # Lines | Linear Ft
Trench Width | Trench Bottom Depth(Low side) | Gravel Depth -


☐ New System ☒ Repair ☐ Expansion System Type: I II (III) IV V VI
System Description:
Repair System Description: Tank
Maintenance Agreement Required: ☐ YES ☒ NO
☒ GRAVITY ☐ PRESSURE

☒ Residence ☐ Business ☐ Other ☐ Slab ☐ Crawl Space ☐ Basement w/plumbing ☒ Basement w/o plumbing
No. Bedrooms | No. Persons | No. Employees

Water Supply: ☒ Private ☐ Public ☐ Community

Comments / Conditions: Pump Crush and fill old Septic tank. Maintain 50' from well with New ST


INITIAL SITE SKETCH

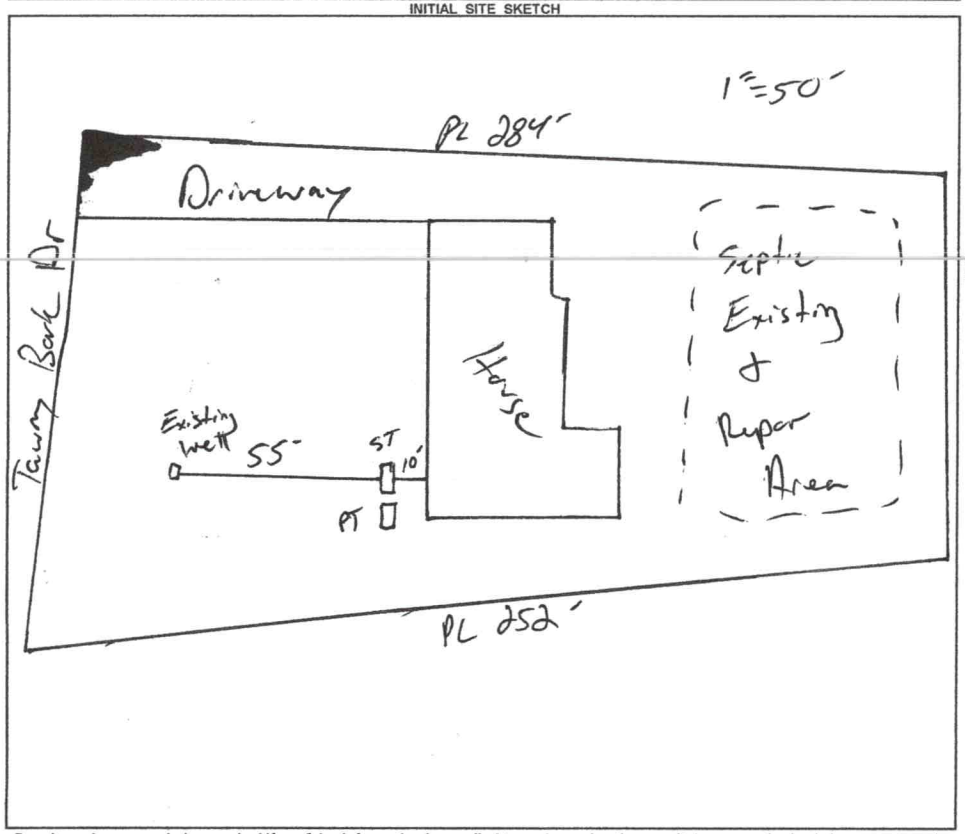

AS BUILT SKETCH

FOR SEPTIC FINAL INSPECTION CALL: 704-664-3703 between 8am-9am the day the inspection is needed. Be sure to speak with an inspector to confirm your time.

7/15/2020: Dellinger mid-seam 1000-gallon tank w/ a Polylok PL-68 effluent filter

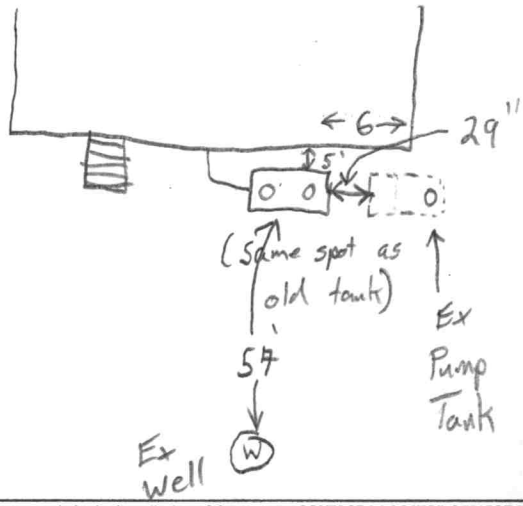

Permit can be suspended or revoked if any false information is supplied toward securing the permit / any unauthorized changes are made to the site / any unauthorized changes are made in the installation of the system. **CONTACT A LOCATOR SERVICE PRIOR TO ANY EXCAVATION**

☐ **IMPROVEMENT PERMIT** *with plat valid without expiration.* ☑ **IMPROVEMENT PERMIT** *with site plan valid for 60 mos.* ☑ **AUTHORIZATION TO CONSTRUCT** *valid for period equal to IMPROVEMENT PERMIT--not to exceed 60 mo.*

Owner / Applicant Signature: | Date: | Installed by: R+H (Brad Russell)

IMPROVEMENT PERMIT by: | Date: 7-8-20 | OPERATION PERMIT by: Tom Chuck | Date: 7/20/2020

AUTHORIZATION TO CONSTRUCT by: | Date: 7-8-20 | Existing System Inspected by: | Date:

FOR SEPTIC FINAL INSPECTION: CALL 704-664-3703 between 8am-9am the day the inspection is needed.