IREDELL COUNTY HEALTH DEPARTMENT

Authorization to Construct

STATESVILLE 704-878-5305 MOORESVILLE 704-664-5281

IMPROVEMENT PERMIT / ~~CERTIFICATE OF COMPLETION~~ / OPERATION PERMIT / EXISTING SYSTEM INSPECTION

PROPERTY DESCRIPTION NO. 23474 DATE 6/13/96 TAX MAP NO. 2F-11-27 4626 96 7417 Watershed: ☑ Yes ☐ No

OWNER OR CONTRACTOR Kevin Combs PHONE: Business _____ Home 663-2416

ADDRESS 117 Poplar Grove Rd Mooresville NC 28115

LOCATION ~~#117 Poplar Grove Rd~~ - Brawley School Rd - TR Poplar Grove Rd - TR Tawny Bark Rd - Corner of Tawny & Sycamore

SUBDIVISION Poplar Grove BLOCK / SECTION _____ LOT 27 LOT AREA _____ SITE CLASS. PS DESIGN FLOW 360 gpd L.T.A.R. 1.35 gpd/ft²

Septic Tank: 1000 Gallons; STB 1012 Date 7/24/96

Pump Tank: 1000 Gallons; PT 17 Date 10/24/96

Pump Make: _____ Model _____ Serial No. _____

Nitrification Field: No Fields 1 Square Feet 980 Linear Feet 360

No Lines 4 Trench Width 36" Max Trench Bottom Depth 36" Gravel Depth 12"

☑ New System ☐ Repair System Type: I (II) III IV V VI

System Description: Pump Conv.

Repair System Description: Pump Panel

Maintenance Agreement Required: ☐ Yes ☑ No

☑ House/Mod. Home No. Bedrooms 3

☐ Mobile Home No. Bathrooms 2

☐ Business No. Employees _____

☐ Other _____

☐ Slab ☐ Crawl Space ☐ Basement w/plumbing ☑ Basement wo/plumbing

Water Supply: ☑ Individual ☐ Community ☐ Public


Comments:

Comments: TANKS, LINES CHECKED NOV. 1ST.


PRESSURE Checked 10/20/96 . CBP

Electrical checked 11/27/96 .

INITIAL SITE SKETCH 1"=40'

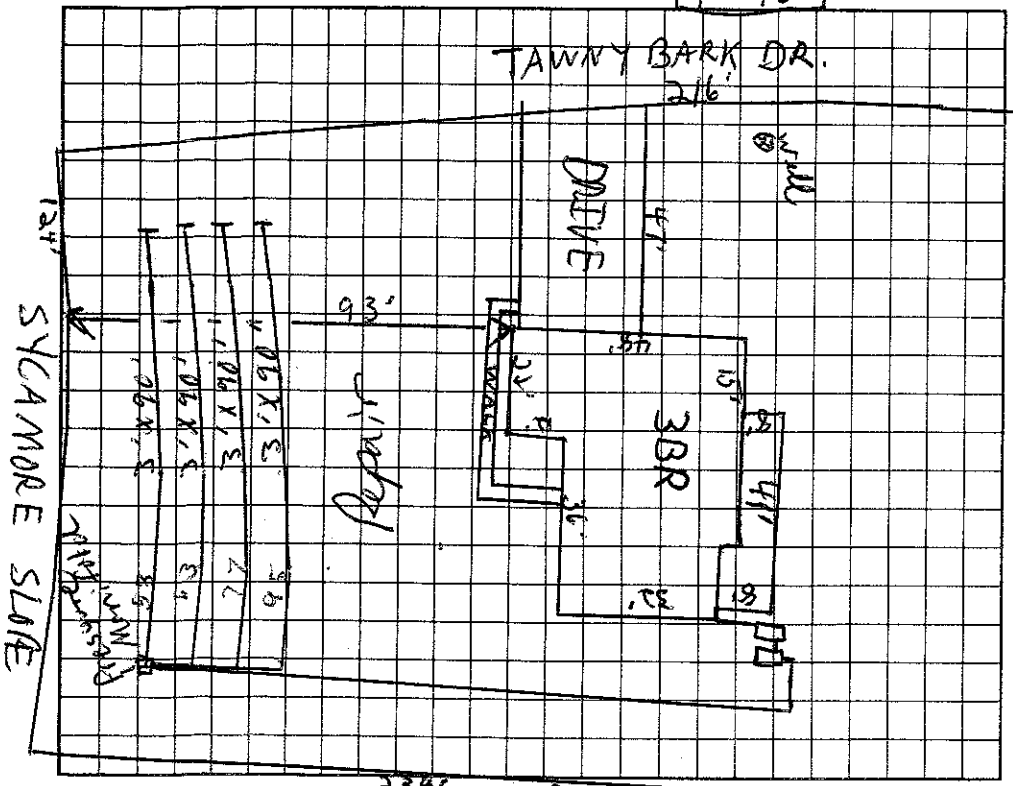

AS BUILT SKETCH

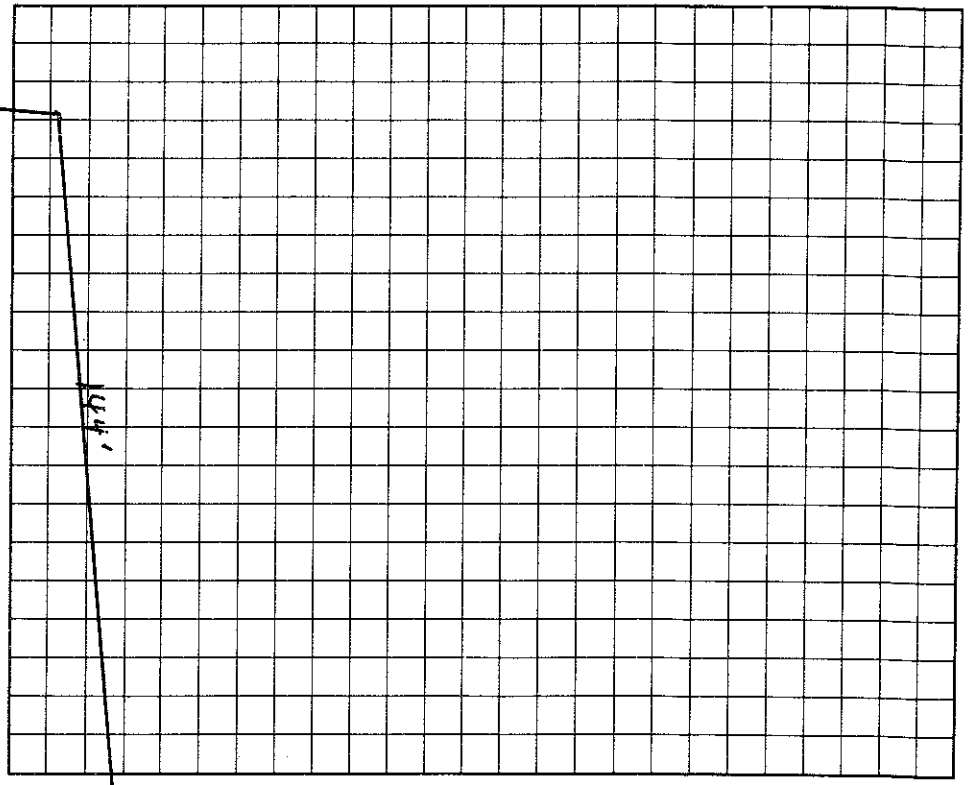

I understand that this permit can be suspended or revoked if any false information is supplied toward ~~securing the permit~~/any unauthorized changes are made to the site/any unauthorized changes are made in the installation of the system.

Signed: _____

Improvement Permit by: C. Rudy Freeman EHSI date 6/13/96

~~Existing System Inspection by:~~ Authorization to Const. C. Rudy Freeman EHSI date 6/13/96

Installed by: RICHARD ABERNATHY

Certificate of Completion by: _____ date _____

Operation Permit by: C. Rudy Freeman date 11/27/96

HEALTH DEPT. COPY: WHITE INSPECTION COPY (FINAL): GREEN OWNER COPY (FINAL): YELLOW INSPECTION COPY (INITIAL): PINK OWNER COPY (INITIAL): GOLD

Authorization to Construct is valid for 60 months from issue date.