1130 BF

IREDELL COUNTY HEALTH DEPARTMENT

Statesville Office (704) 878-5305 · Mooresville Office (704) 660-3625 PERMIT # 172619

IMPROVEMENT PERMIT / AUTHORIZATION TO CONSTRUCT / OPERATION PERMIT / EXISTING SYSTEM

PIN # 4626-96-9394

APPLICANT: Brooks Henderson APPLICANT ADDRESS: 20515 Deep Cove Ct. Cornelius NC 28031

SITE ADDRESS: 236 Tawny Bark Dr Mooresville 28117 PHONE: 704-201-1429 ALT. PHONE:

SITE DIRECTIONS: Brawley Sch Rd, TR on Poplar Grove Rd, TR on Tawny Bark, @ end on R

SUBDIVISION: Poplar Grove SECTION: LOT # 38 LOT AREA: .612ac DESIGN FLOW: 480gpd L.T.A.R.: 0.3

Septic Tank	1000 (gal)	STB	794	Date	10-14-14	☑ New System ☐ Repair ☐ Expansion	System Type: I II (III) IV V VI
Pump Tank	1000 (gal)	PT	37	Date	10-10-14	System Description:	PM 25% Reduction
Pump Make	Zoeller	Model	N137	Serial #		Repair System Description:	LP PPBPS
# Nitrification Fields	1	# Lines	5	Linear Ft:	400	Maintenance Agreement Required:	☐ YES ☑ NO
Trench Width	36"	Max. Trench Bottom Depth	24"	Gravel Depth	N/A		☐ GRAVITY ☑ PRESSURE

☑ Residence ☐ Business ☐ Other ☐ Slab ☐ Basement w/plumbing

No. Bedrooms 4 No. Persons 8 No. Employees

☑ Crawl Space ☐ Basement w/o plumbing


Water Supply: ☑ Private ☐ Public ☐ Community

Comments / Conditions: Install System as drawn with 24" trench bottom


11/21/14 Checked tanks & drainlines

2/16/15 Set 2PT pressure, checked elect & alarm.

INITIAL SITE SKETCH

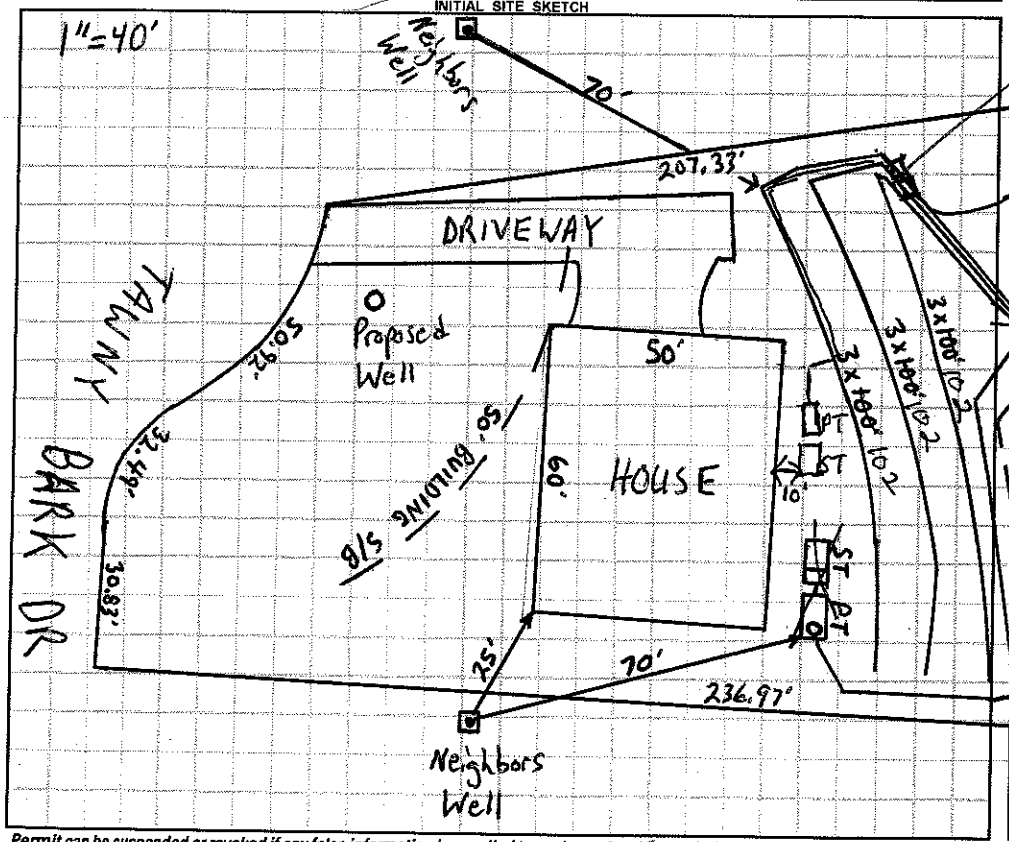

AS BUILT SKETCH

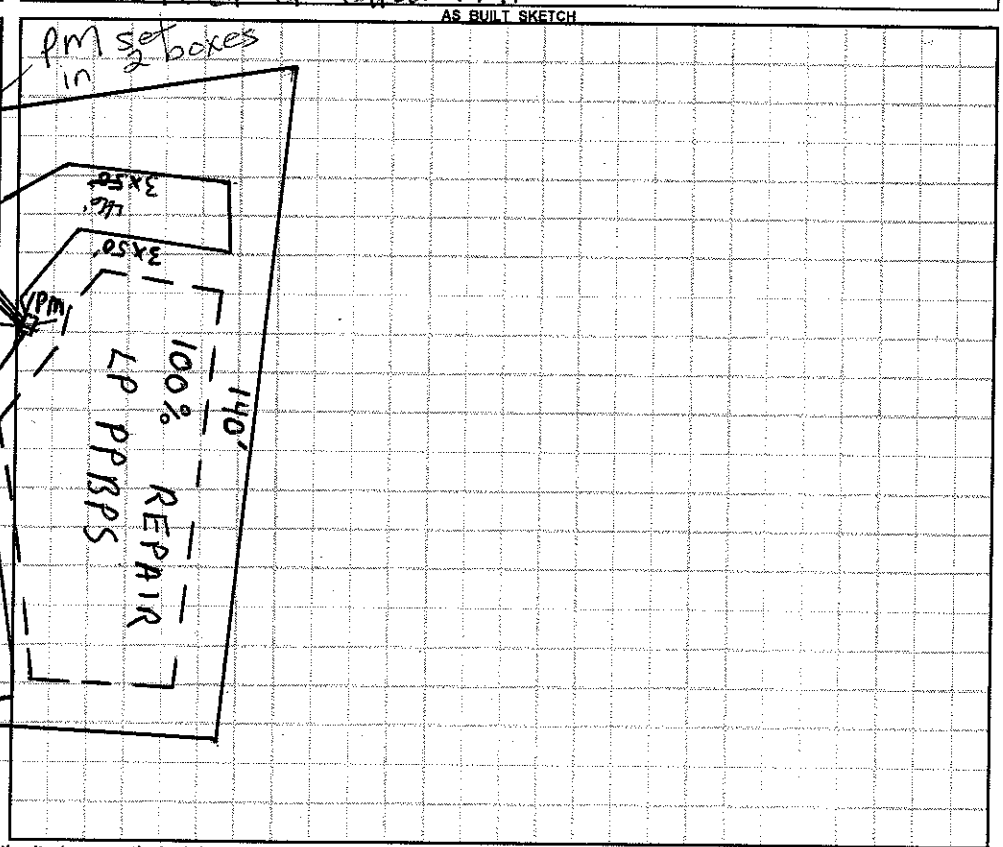

Permit can be suspended or revoked if any false information is supplied toward securing the permit / any unauthorized changes are made to the site / any unauthorized changes are made in the installation of the system. **CONTACT A LOCATOR SERVICE PRIOR TO ANY EXCAVATION**

☐ **IMPROVEMENT PERMIT** *with plat* valid without expiration. ☑ **IMPROVEMENT PERMIT** *with site plan* valid for 60 mos. ☑ **AUTHORIZATION TO CONSTRUCT** valid for period equal to IMPROVEMENT PERMIT--not to exceed 60 mo.

Owner / Applicant Signature: Date: 11-14-13 Installed by: Russell Williams

IMPROVEMENT PERMIT by: Date: 11-6-13 OPERATION PERMIT by: Date: 2/16/15

AUTHORIZATION TO CONSTRUCT by: Date: 3-17-14 Existing System Inspected by: Date:

Health Dept. Copy - WHITE Applicant (Final Approval) - YELLOW Applicant (Conditional Approval) - PINK