IREDELL COUNTY HEALTH DEPARTMENT

Statesville Office (704) 878-5305 Mooresville Office (704) 660-3625 PERMIT # 210143

IMPROVEMENT PERMIT / AUTHORIZATION TO CONSTRUCT / OPERATION PERMIT (EXISTING SYSTEM)

PIN # 4626-99-0639

APPLICANT: JANE ELKOVICH APPLICANT ADDRESS: 778 BEATEN PATH RD. MOORESVILLE NC. 28117

SITE ADDRESS: SAME PHONE: 704-663-7627 ALT. PHONE: 910-551-7369 - JOHN

SITE DIRECTIONS: BRAWLEY SCH. TR BLUME TL BEATEN PATH TL CICERO TL SHAVENDER TL BEATEN PATH NEXT LAST ON R

SUBDIVISION: CL&T SECTION: 9 LOT # 13 LOT AREA: ~1.9 AC DESIGN FLOW: 360 L.T.A.R.: —


Septic Tank	1000 (gal)	STB	Date	☐ New System ☐ Repair ☐ Expansion	System Type: I (II) III IV V VI	☑ Residence	No. Bedrooms	3	Water Supply
Pump Tank	(gal)	PT	Date	System Description:	EXISTING	☐ Business	No. Persons		☑ Private
Pump Make	Model		Serial #	Repair System Description:		☐ Other	No. Employees		☐ Public
# Nitrification Fields	# Lines		Linear Ft:	Maintenance Agreement Required:	☐ YES ☐ NO	☐ Slab	☐ Crawl Space		☐ Community
Trench Width	10'	Max. Trench Bottom Depth		Gravel Depth	☐ GRAVITY ☐ PRESSURE	☑ Basement w/plumbing		☐ Basement w/o plumbing	

Comments / Conditions: EXISTING 10'X55' BED - WHEN INSTALLED MET 50 FOOT SETBACK - EROSION OF SHORELINE NOW HAS BED <50' FROM 760 CONTOUR - OWNER MADE AWARE OF THIS, EXISTING HOUSE TO BE REMOVED

INITIAL SITE SKETCH

MAKE ROOM FOR NEW 3 BEDROOM W BASEMENT HOUSE.

AS BUILT SKETCH

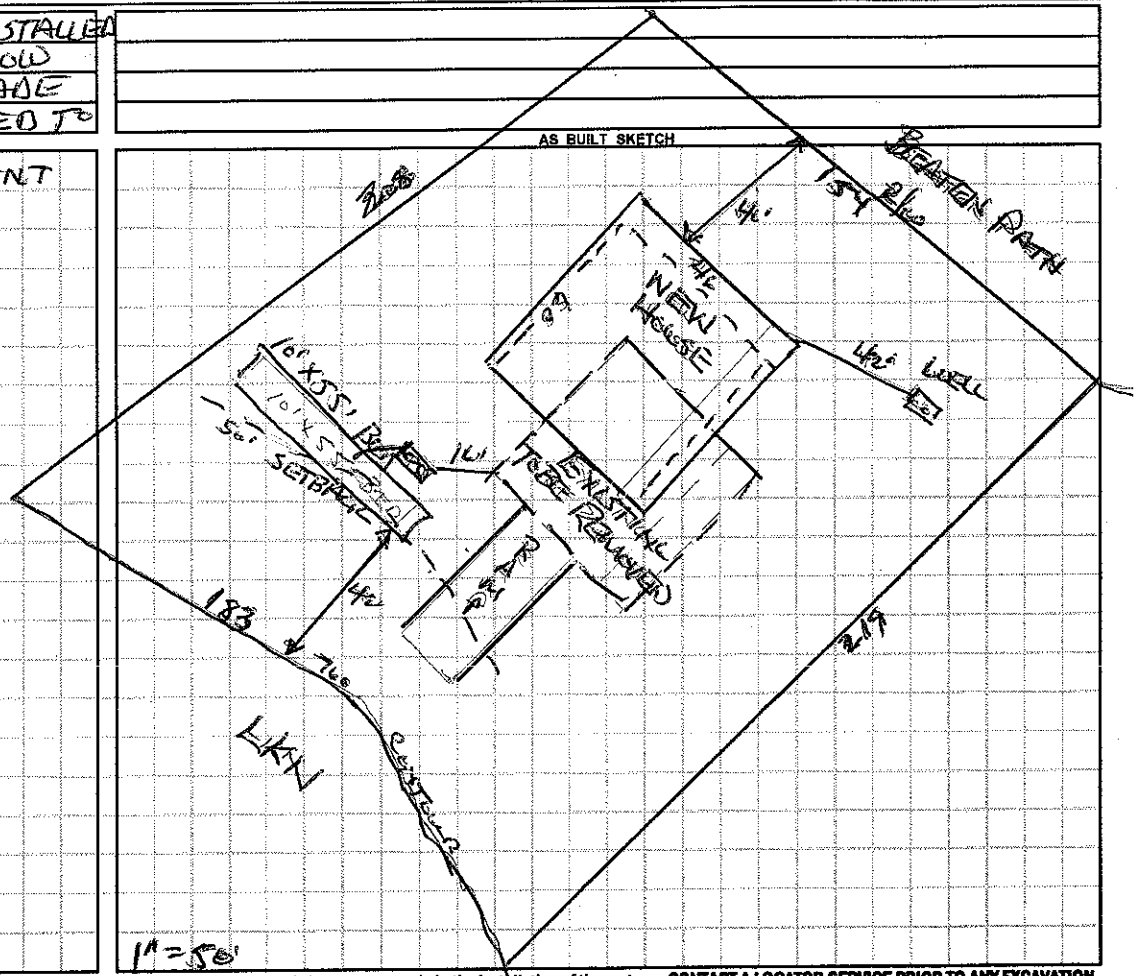

Permit can be suspended or revoked if any false information is supplied toward securing the permit / any unauthorized changes are made to the site / any unauthorized changes are made in the installation of the system. **CONTACT A LOCATOR SERVICE PRIOR TO ANY EXCAVATION**

☐ **IMPROVEMENT PERMIT** *with plat valid without expiration.* ☐ **IMPROVEMENT PERMIT** *with site plan valid for 60 mos.* ☐ **AUTHORIZATION TO CONSTRUCT** *valid for period equal to IMPROVEMENT PERMIT--not to exceed 60 mo.*

Owner / Applicant Signature: Jane Volkovich Date: 06/10/15 Installed by:

IMPROVEMENT PERMIT by: Date: OPERATION PERMIT by: Date:

AUTHORIZATION TO CONSTRUCT by: Date: Existing System Inspected by: Wesley Sparks Date: 6/9/2015

Health Dept. Copy - WHITE Applicant (Final Approval) - YELLOW Applicant (Conditional Approval) - PINK